


U. S. PUBLIC LAND SURVEY MONUMENT RECORD

SECTION 1 T 17 N, R 5 W, TOWN OF BURNS
 LA CROSSE COUNTY

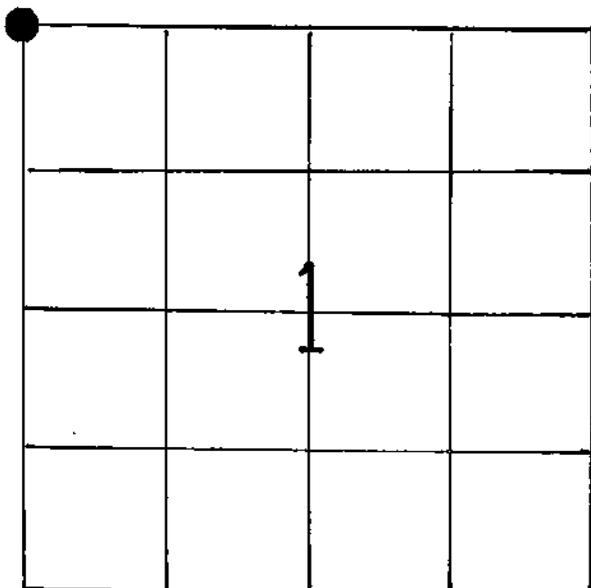

LOCATION OF LANDMARK

Crew: WILLIAM C. JUNG
 PETER F. FOLLANSBEE

Date: 9/24/1992

Describe any record evidence, monument evidence, testimonial evidence or any other material evidence you considered and whether the monument was found or restored through acceptance of an obliterated evidence location.

I set the corner off of what I feel is the original government bearing tree to the Southwest. The corner was monumented with a Lunde and falls S89°W, 2.36' from the fence intersection.


Describe or show any material discrepancy between the location of the restored corner and that of the corner previously restored or reestablished.

None Known.

WISCONSIN COORDINATE SYSTEM
North
East
Theta Angle
Horiz. Order
Vert. Order
TYPE OF LANDMARK
Set brass cap Lunde marker.
BEARINGS ARE REFERENCED TO
True North (± 02')

RECORD OF DURABLE WITNESS MONUMENTS
MAGNETIC


NO	DESCRIPTION	BEARING	DISTANCE
1	Set P.K. Nail on NW-side 18" White Oak	S 39° W	32.05 Ft.
2	Set P.K. Nail on NE-side 19" White Oak	N 59° W	8.57 Ft.
3	Set P.K. Nail on S-side 13" White Oak	N 70° E	44.44 Ft.
4	Set P.K. Nail on W-side 19" White Oak	S 07° E	35.32 Ft.

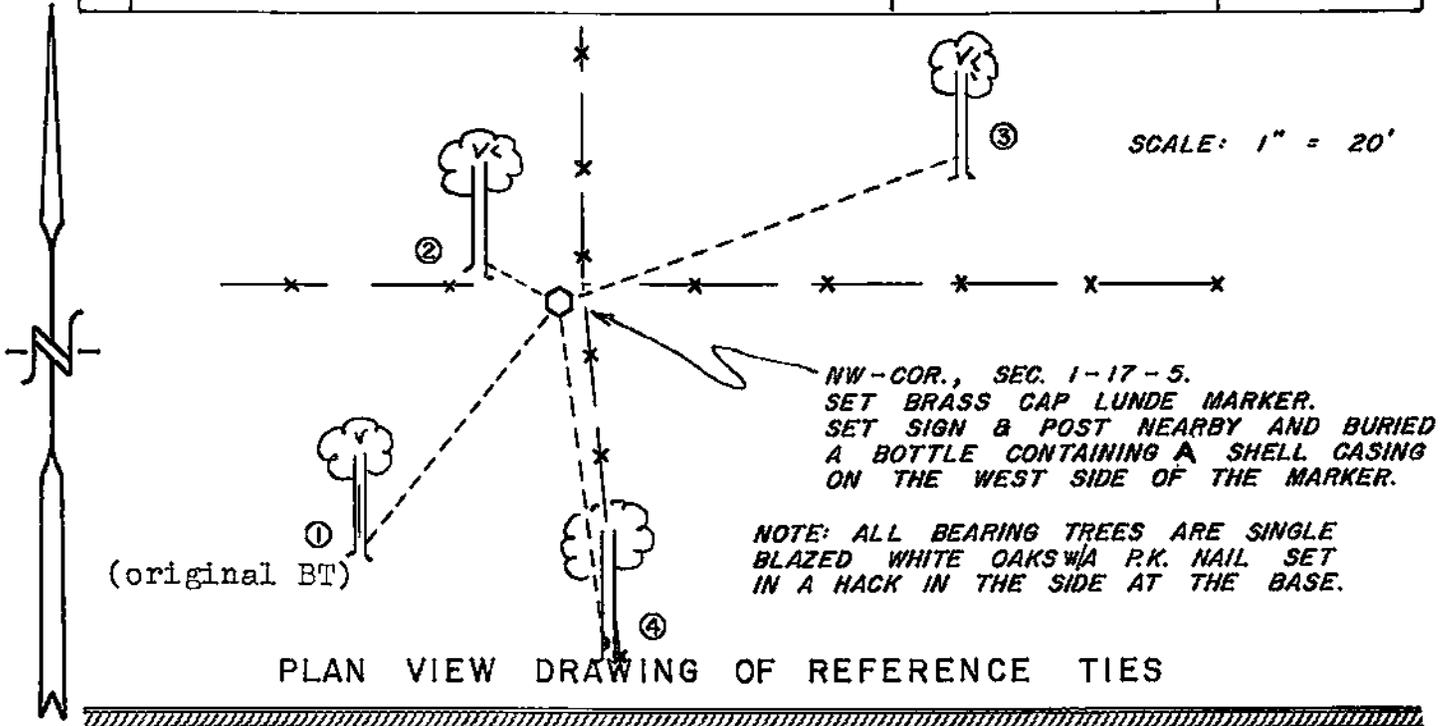

PLAN VIEW DRAWING OF REFERENCE TIES

MAP SHOWING DISTANCE AND DIRECTION TO OTHER PUBLIC LAND SURVEY CORNERS USED FOR REESTABLISHING THE CORNER

(not to scale)

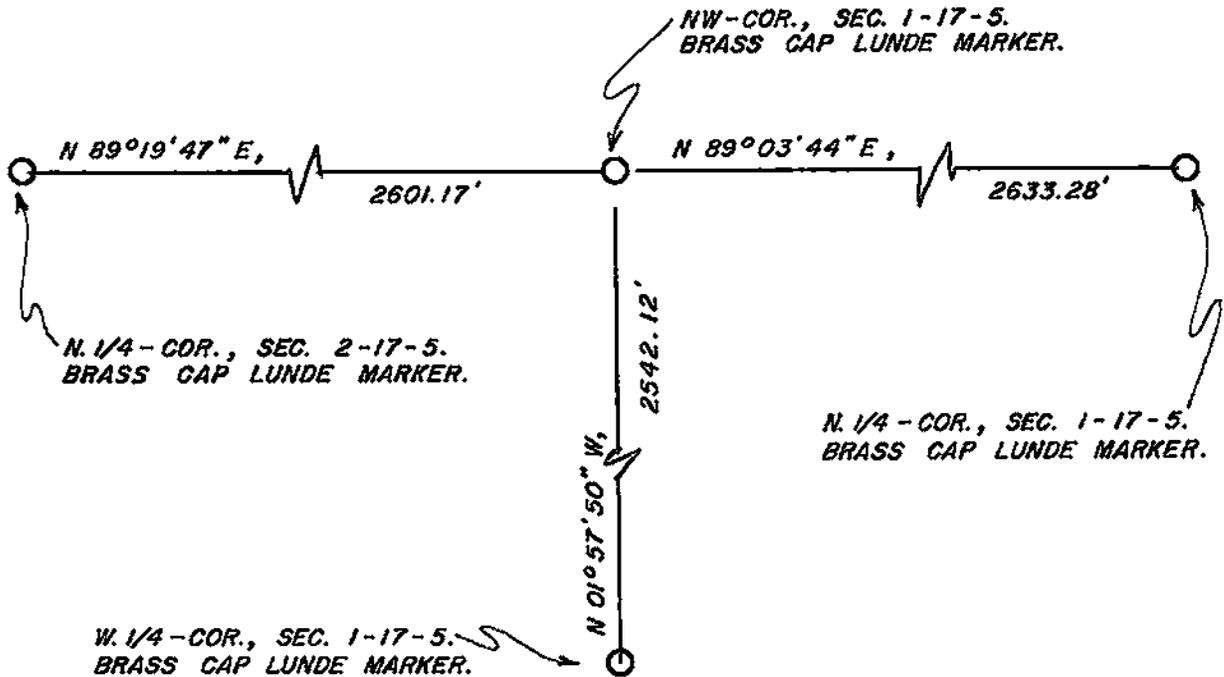

I, William C. Jung, Deputy County Surveyor
HEREBY CERTIFY THAT THE CORNER LOCATION SHOWN ON THIS RECORD
WAS DETERMINED BY ME OR UNDER MY DIRECTION AND CONTROL AND
THAT THIS U. S. PUBLIC LAND SURVEY MONUMENT RECORD IS CORRECT
AND COMPLETE TO THE BEST OF MY KNOWLEDGE AND BELIEF.

William C. Jung
Signature

December 23, 1992
Date



Seal