


U. S. PUBLIC LAND SURVEY MONUMENT RECORD

SECTION 2 T 17 N, R 5 W, TOWN OF BURNS

LA CROSSE COUNTY

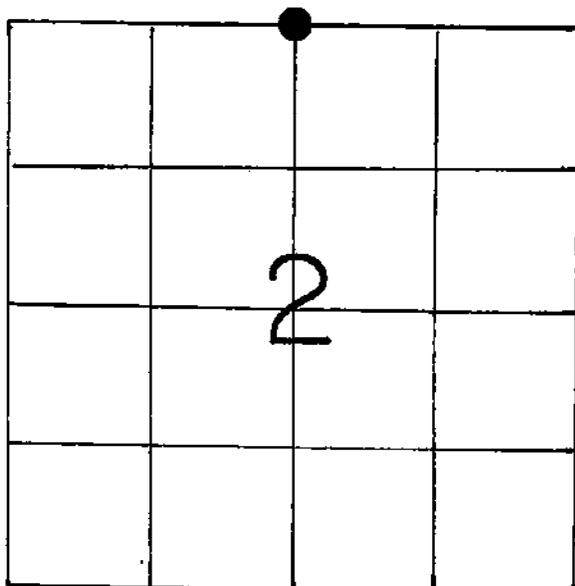

LOCATION OF LANDMARK

WISCONSIN COORDINATE SYSTEM

North

East

Theta Angle

Horiz. Order

Vert. Order

TYPE OF LANDMARK

Set brass cap Lunde marker.

BEARINGS ARE REFERENCED TO

True North ($\pm 02'$)

Crew: WILLIAM C. JUNG

Date: 10/06/1992

Describe any record evidence, monument evidence, testimonial evidence or any other material evidence you considered and whether the monument was found or restored through acceptance of an obliterated evidence location.



I set the corner by single proportionate measurement. I rejected the fence corner to the South. Mr. Cole to the North told me that local landowners knew that the fence was off.

Describe or show any material discrepancy between the location of the restored corner and that of the corner previously restored or reestablished.

None Known.

**RECORD OF DURABLE WITNESS MONUMENTS
MAGNETIC**

NO	DESCRIPTION	BEARING	DISTANCE
1	Set P.K. Nail on NE-side 10" Hickory	N 23° W	Sl.=10.51'
2	Set P.K. Nail on SE-side 4" Oak	S 56° W	36.31 Ft.
3	Set P.K. Nail on SE-side 9" Hickory	S 41° W	26.57 Ft.
4	Set P.K. Nail on E-side 7" Maple	S 02° E	28.99 Ft.

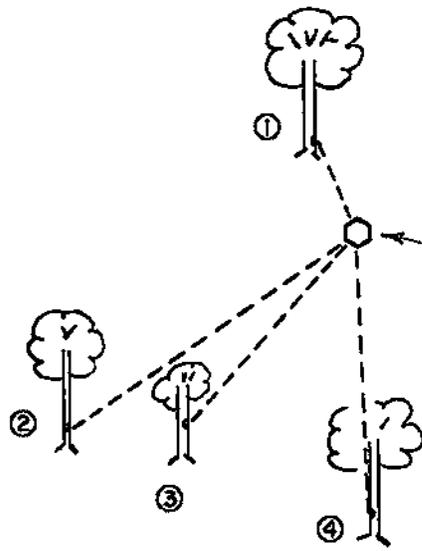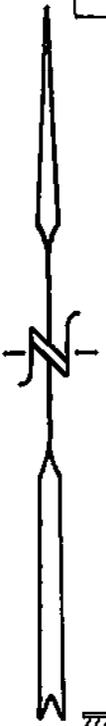

NOTE: DISTANCES ARE MEASURED TO P.K. NAILS SET IN THE SIDES OF UNBLAZED BEARING TREES.


N. 1/4 - COR., SEC. 2-17-5.
SET BRASS CAP LUNDE MARKER. BURIED A WHISKEY BOTTLE CONTAINING A SHELL CASING AND SET A POST WITH AN ATTACHED SIGN NEAR THE MARKER. LAID A LARGE PIECE OF SANDSTONE ON THE EAST SIDE.
S10.5°E, 48' is the old fence corner.

SCALE: 1" = 20'

PLAN VIEW DRAWING OF REFERENCE TIES

MAP SHOWING DISTANCE AND DIRECTION TO OTHER PUBLIC LAND SURVEY CORNERS USED FOR REESTABLISHING THE CORNER


(not to scale)

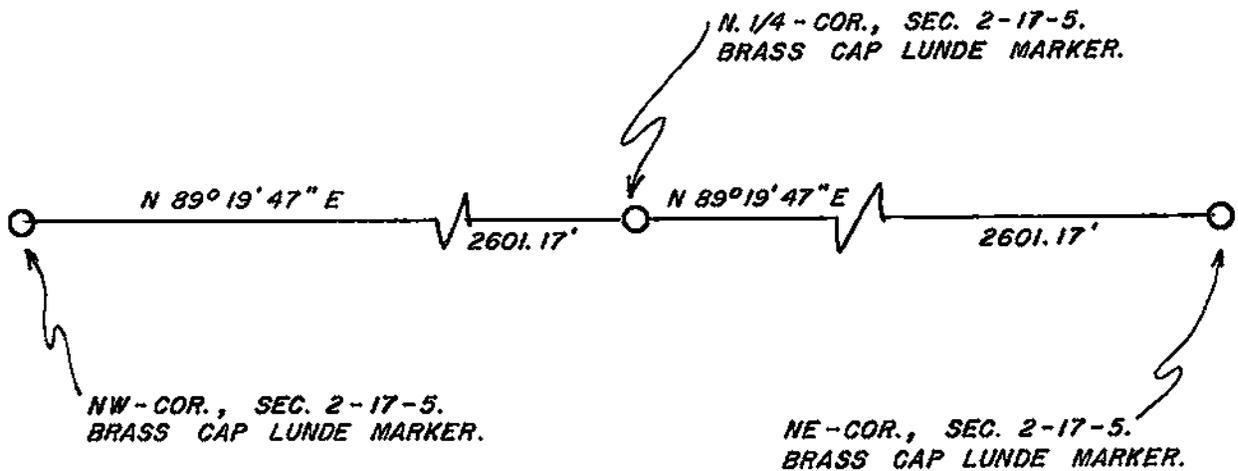

I, William C. Jung, Deputy County Surveyor
HEREBY CERTIFY THAT THE CORNER LOCATION SHOWN ON THIS RECORD WAS DETERMINED BY ME OR UNDER MY DIRECTION AND CONTROL AND THAT THIS U. S. PUBLIC LAND SURVEY MONUMENT RECORD IS CORRECT AND COMPLETE TO THE BEST OF MY KNOWLEDGE AND BELIEF.

William C. Jung
Signature

December 23, 1992
Date

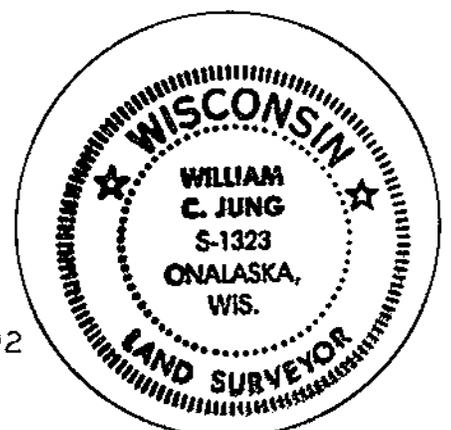

Seal