

CERTIFICATE

CERTIFIED LAND CORNER

I, Harley A. Sime, do hereby certify that on the 5 day of May, 1975, I found (evidence) (no evidence) of the N.W. corner of Section 6, T.17 N., R. 4W, Fourth Principal Meridian, and I re-established said corner according to the Wisconsin Statutes as shown and described hereon.

Dated this 14 day of Jan, 1976.

[Signature]
County Surveyor

History of original corner establishment:

Description of corner evidence found:




Accepted occupied fence corner as the best available evidence. This corner fits the N corner North for bearing and distance (2623±). It is also on line with the fence corner at the N.E. corner of Sec. 6 and the fence at the NW corner of Sec. 6. The overall distance between the N.W. cor. & N.E. cor. when split proportionately fits the present occupation. The West line of Section 6 also fits fairly well.

Note: The terrain in this area is very rugged, accounting for the short distances in the old surveys.

Description of corner and witness monuments, references and accessories used to perpetuate the original or re-established location of this corner:

Witnesses to corner location:

W.C. Jung - Crew Chief
D. Maliet

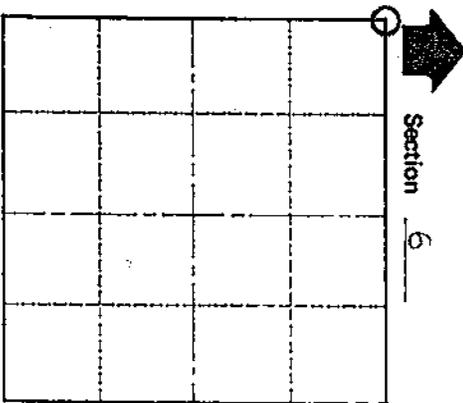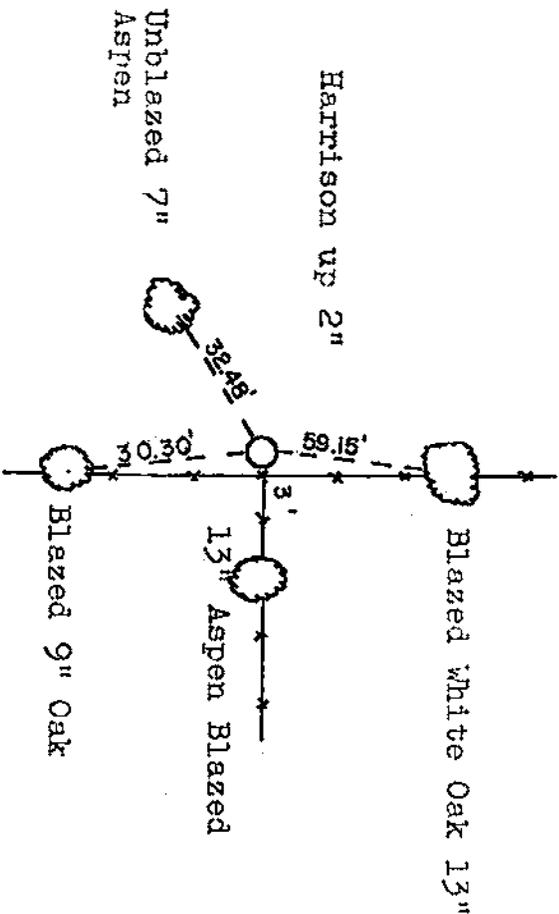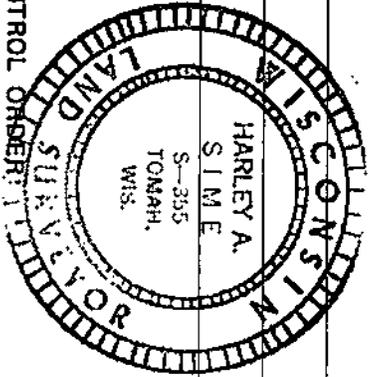

Nails and Caps (n&c) in all trees.

WISCONSIN COORDINATE SYSTEM

Horizontal	East (X)	North (Y)	Elevation (Z)	Zone
Vertical				
Corner				
Control Sta. Name				

City, Village or Town Sparta

County of Monroe