


## U. S. PUBLIC LAND SURVEY MONUMENT RECORD

SECTION 12 T 17 N, R 6 W, TOWN OF HAMILTON

LA CROSSE COUNTY

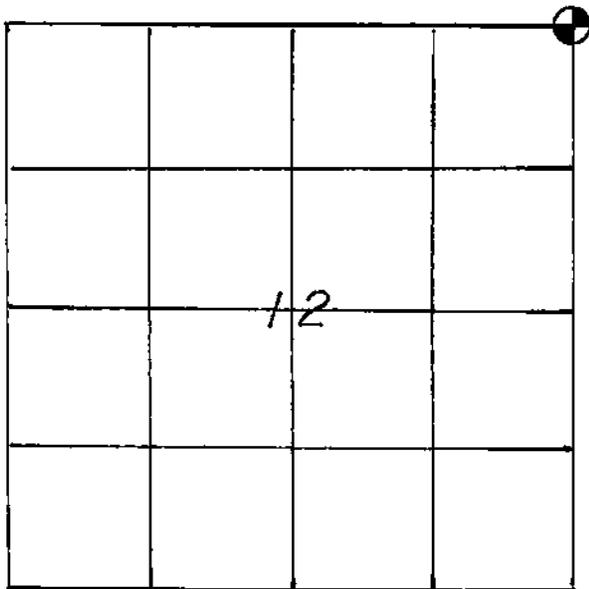

LOCATION OF LANDMARK

DATE: 12-19-86

CREW: BILL JUNG, PERRY DAHL

WISCONSIN COORDINATE SYSTEM

North

East

Theta Angle

Horiz. Order

Vert. Order

TYPE OF LANDMARK

1 1/4" IRON PIPE

BEARINGS ARE REFERENCED TO

True North

Date: 8-22-94

Crew: Bill Jung, Pete Follansbee

Describe any record evidence, monument evidence, testimonial evidence or any other material evidence you considered and whether the monument was found or restored through acceptance of an obliterated evidence location.

Greg Hofmeister set an iron pipe at the corner in 1983. I accepted this pipe as the corner.

Describe or show any material discrepancy between the location of the restored corner and that of the corner previously restored or reestablished.

None known.

RECORD OF DURABLE WITNESS MONUMENTS  
MAGNETIC

NO	DESCRIPTION	BEARING	DISTANCE
1	P.K. NAIL IN DOUBLE-BLAZED 7" OAK	N71°W	28.30'
2	P.K. NAIL IN DOUBLE-BLAZED 32" OAK	N48°E	46.35'
3	<del>NAIL IN DOUBLE-BLAZED 12" HICKORY</del>	<del>N78°E</del>	<del>2.66'</del>
4	NAIL IN DOUBLE-BLAZED 9" ELM	S17°E	18.32'

(gone)

Set sign and post near  
Existing 1 1/4" iron pipe,  
up 4" at the corner

(not to scale)




To the center of a  
grown over blaze on  
the side of a 8"  
birch

(blaze is on South side)

PLAN VIEW DRAWING OF REFERENCE TIES

MAP SHOWING DISTANCE AND DIRECTION TO OTHER PUBLIC LAND  
SURVEY CORNERS USED FOR REESTABLISHING THE CORNER

(not to scale)

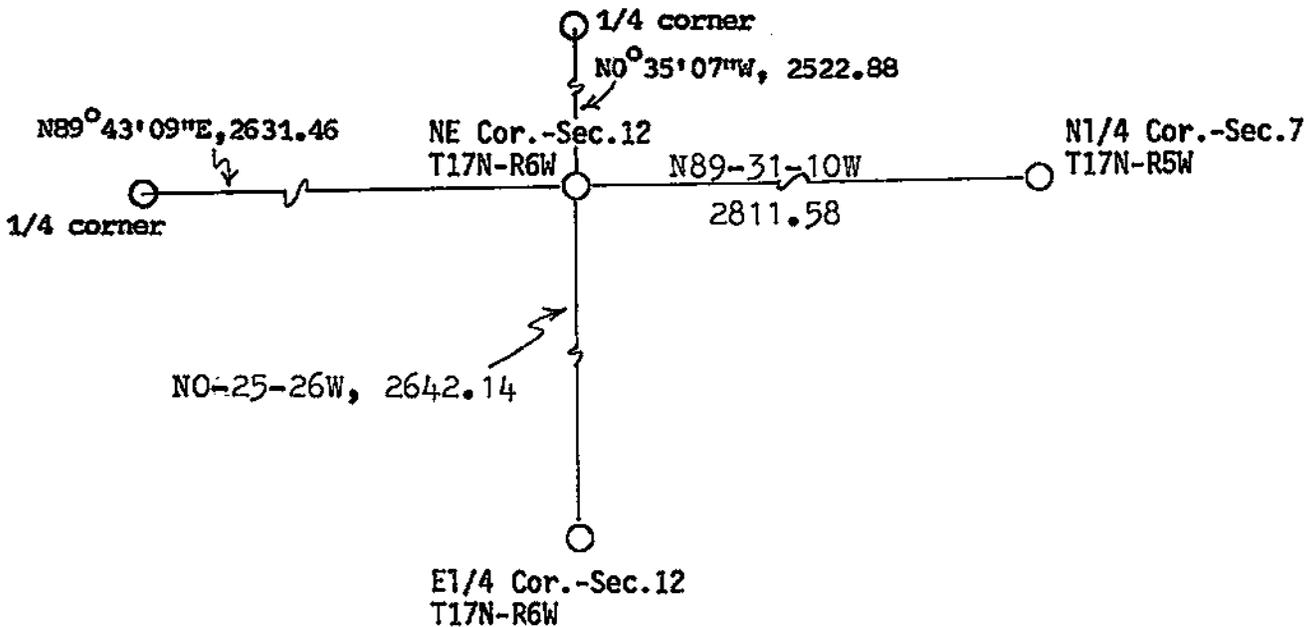

I, William C. Jung, Deputy County Surveyor,  
HEREBY CERTIFY THAT THE CORNER LOCATION SHOWN ON THIS RECORD  
WAS DETERMINED BY ME OR UNDER MY DIRECTION AND CONTROL AND  
THAT THIS U. S. PUBLIC LAND SURVEY MONUMENT RECORD IS CORRECT  
AND COMPLETE TO THE BEST OF MY KNOWLEDGE AND BELIEF.

*William C. Jung*  
Signature

December 31, 1986  
Date

Revised: March 2, 1995 *asej*



Seal