


U. S. PUBLIC LAND SURVEY MONUMENT RECORD

SECTION 12 T 17 N, R 6 W, TOWN OF HAMILTON

LA CROSSE COUNTY

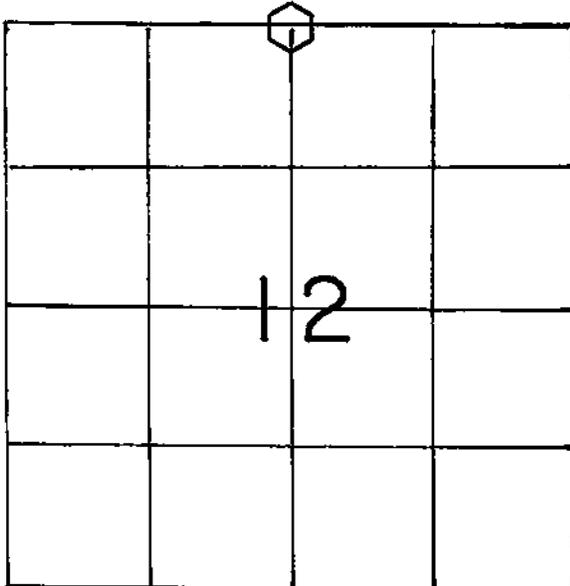

LOCATION OF LANDMARK

Crew: WILLIAM C. JUNG
PETER F. FOLLANSBEE

Date: 9/15/1994

Describe any record evidence, monument evidence, testimonial evidence or any other material evidence you considered and whether the monument was found or restored through acceptance of an obliterated evidence location.

I set this corner by single proportionate measurement and monumented it with a brass capped Lunde marker.

Describe or show any material discrepancy between the location of the restored corner and that of the corner previously restored or reestablished.

None Known.

WISCONSIN COORDINATE SYSTEM

North

East

Theta Angle

Horiz. Order

Vert. Order

TYPE OF LANDMARK

Set brass cap Lunde marker.


BEARINGS ARE REFERENCED TO

True North.

RECORD OF DURABLE WITNESS MONUMENTS
MAGNETIC


NO	DESCRIPTION	BEARING	DISTANCE
1	Set P.K. Nail in S.-side 8" Hickory	S 73° W	54.43 Ft.
2	Set P.K. Nail in NW-side 3½" Hickory	N 40° E	7.55 Ft.
3	Set P.K. Nail in N.-side 3" Hickory	S 70° E	4.36 Ft.
4	Set P.K. Nail in W.-side 5½" Hickory	S 04° E	9.71 Ft.

N.¼-Cor., Sec. 12-17-6.
Set brass cap Lunde marker, flush, in the woods on top of the bank of the southerly side of a small ravine. Buried a Rum bottle containing a brass shell casing on the SW-side and set a sign & post on the east side of the marker.

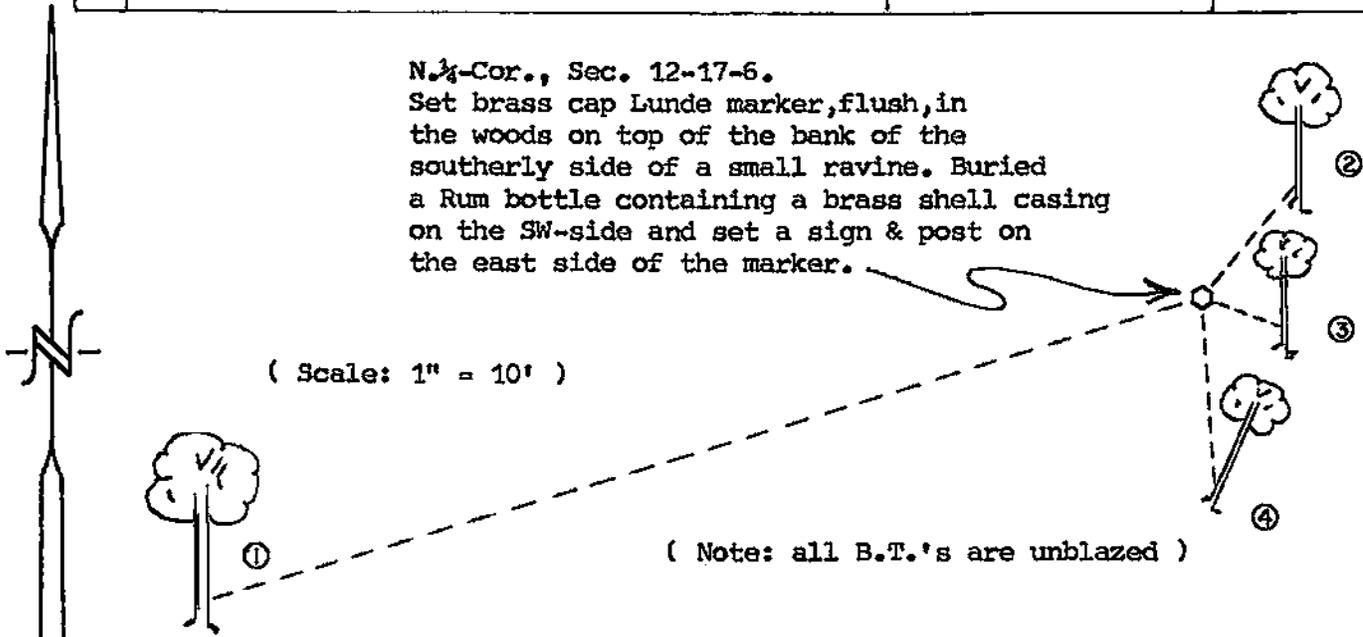

PLAN VIEW DRAWING OF REFERENCE TIES

MAP SHOWING DISTANCE AND DIRECTION TO OTHER PUBLIC LAND SURVEY CORNERS USED FOR REESTABLISHING THE CORNER
(not to scale)

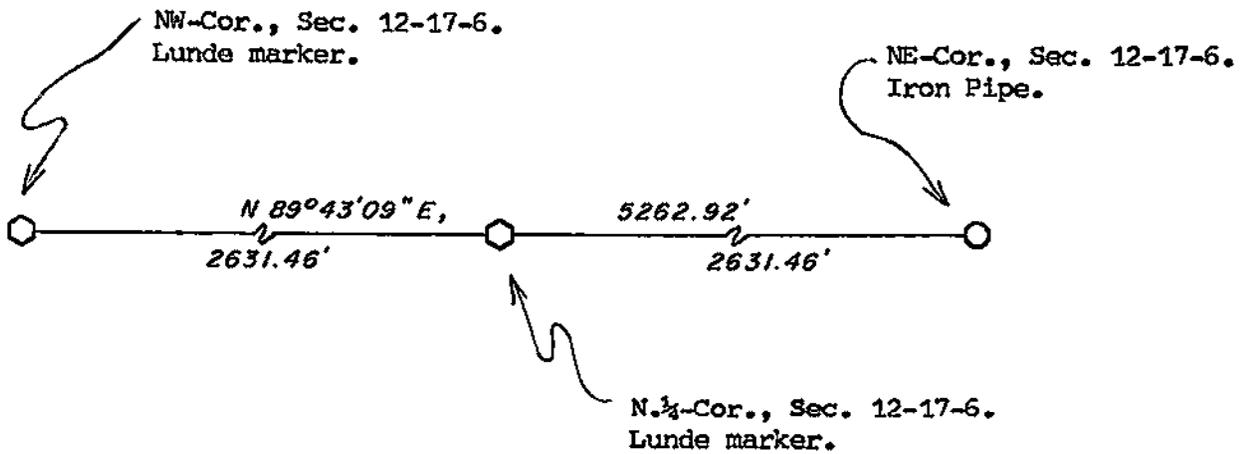

I, William C. Jung, County Surveyor
HEREBY CERTIFY THAT THE CORNER LOCATION SHOWN ON THIS RECORD WAS DETERMINED BY ME OR UNDER MY DIRECTION AND CONTROL AND THAT THIS U. S. PUBLIC LAND SURVEY MONUMENT RECORD IS CORRECT AND COMPLETE TO THE BEST OF MY KNOWLEDGE AND BELIEF.

William C. Jung 2/7/95
Signature Date



Seal