


U. S. PUBLIC LAND SURVEY MONUMENT RECORD

SECTION 1 T 17 N, R 6 W, TOWN OF HAMILTON
 LA CROSSE COUNTY

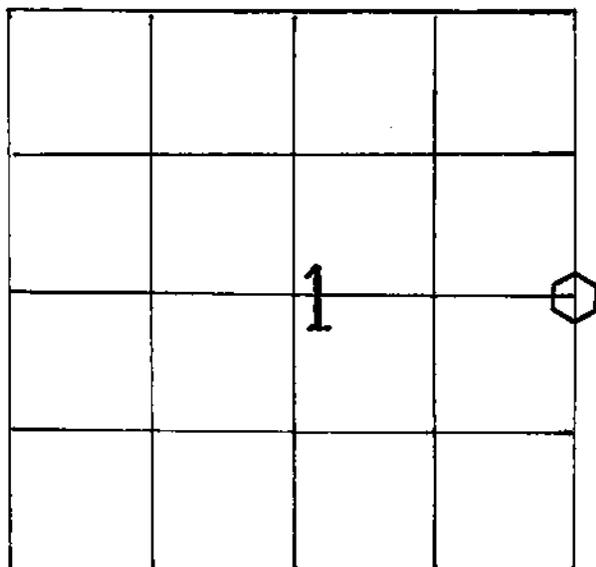

LOCATION OF LANDMARK

Crew: WILLIAM C. JUNG
 PETER F. FOLLANSBEE

Date: 2/01/1995

Describe any record evidence, monument evidence, testimonial evidence or any other material evidence you considered and whether the monument was found or restored through acceptance of an obliterated evidence location.

I set the corner in the old occupied East-West fence and on line with the section corners to the North and South. I feel that this best fits the evidence found on the Town line and in Section 1. I set a Lunde marker at the corner.

Describe or show any material discrepancy between the location of the restored corner and that of the corner previously restored or reestablished.

Greg Hofmeister had set an iron pipe at this corner in 1983. It is 23.71' to the East. I do not agree with this iron pipe.

WISCONSIN COORDINATE SYSTEM

North

East

Theta Angle

Horiz. Order

Vert. Order

TYPE OF LANDMARK

Set brass cap Lunde marker.

BEARINGS ARE REFERENCED TO

True North.

