


U. S. PUBLIC LAND SURVEY MONUMENT RECORD

SECTION 12 T 17 N, R 6 W, TOWN OF HAMILTON
 LA CROSSE COUNTY

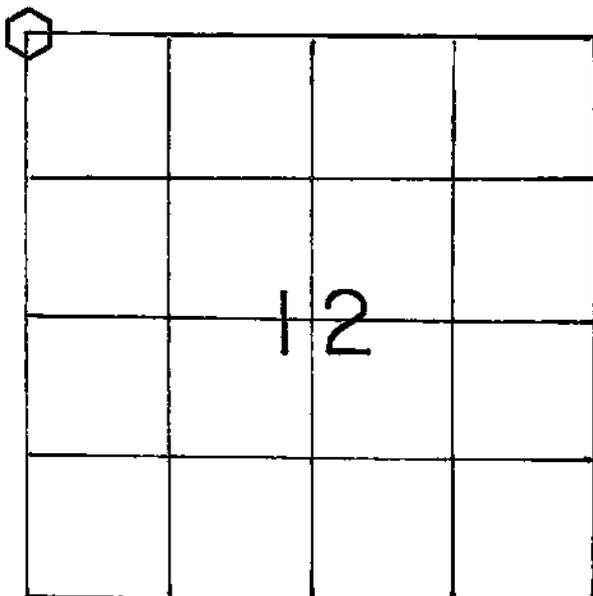

LOCATION OF LANDMARK

WISCONSIN COORDINATE SYSTEM
North
East
Theta Angle
Horiz. Order
Vert. Order
TYPE OF LANDMARK
Set brass cap Lunde marker.
BEARINGS ARE REFERENCED TO
True North.

Crew: WILLIAM C. JUNG
 PETER F. FOLLANSBEE
 Date: 8/04/1994
 9/15/1994

Describe any record evidence, monument evidence, testimonial evidence or any other material evidence you considered and whether the monument was found or restored through acceptance of an obliterated evidence location.


I accepted the old occupied fence corner as the best available evidence of the original government corner position and monumented it with a brass capped Lunde marker.

Describe or show any material discrepancy between the location of the restored corner and that of the corner previously restored or reestablished.

None Known.


RECORD OF DURABLE WITNESS MONUMENTS
MAGNETIC

NO	DESCRIPTION	BEARING	DISTANCE
1	Set P.K. Nail in E.-side 3" Basswood	N 10° E	19.75 Ft.
2	Set P.K. Nail in SE-side 4" Hickory	N 45° E	26.54 Ft.
3	Set P.K. Nail in S.-side 5½" Hickory	N 83° E	6.53 Ft.
4	Set P.K. Nail in NE-side 4" Hickory	Southerly ±	Sl. = 27.47'

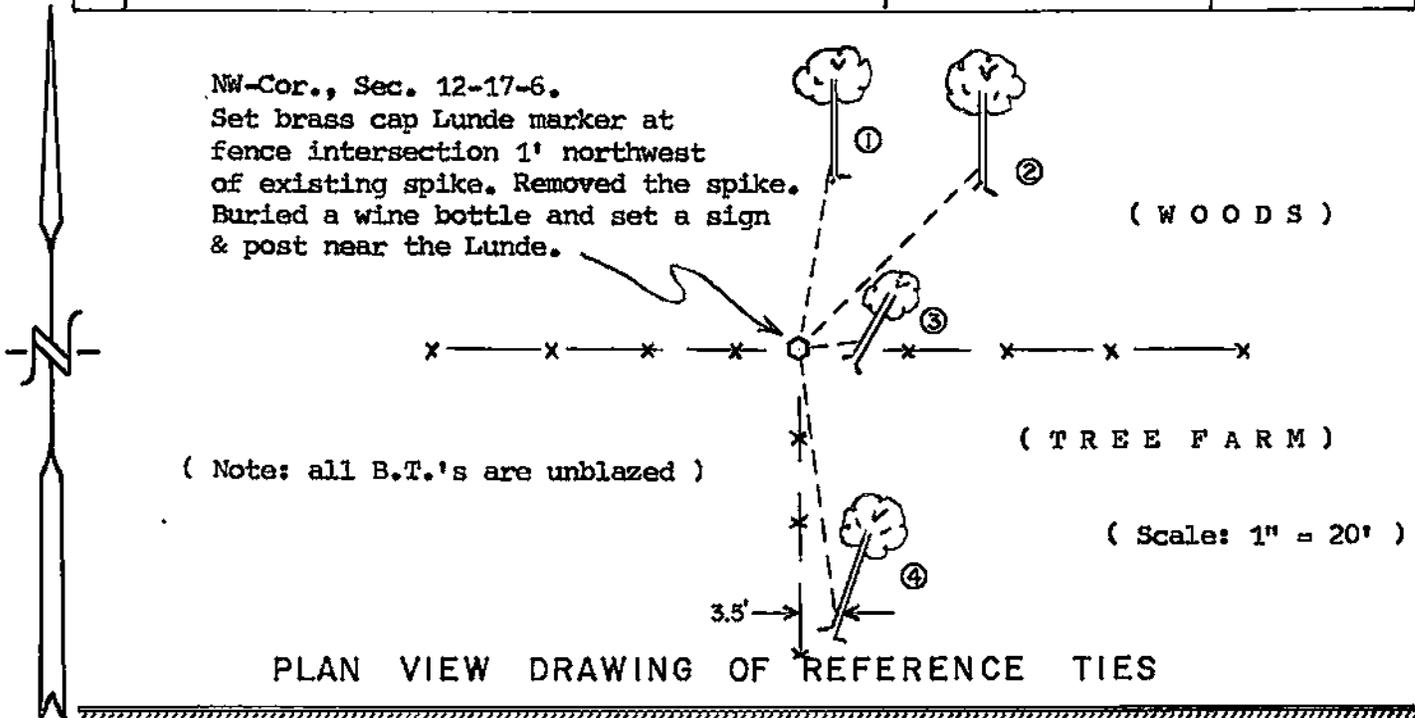

MAP SHOWING DISTANCE AND DIRECTION TO OTHER PUBLIC LAND SURVEY CORNERS USED FOR REESTABLISHING THE CORNER


(not to scale)

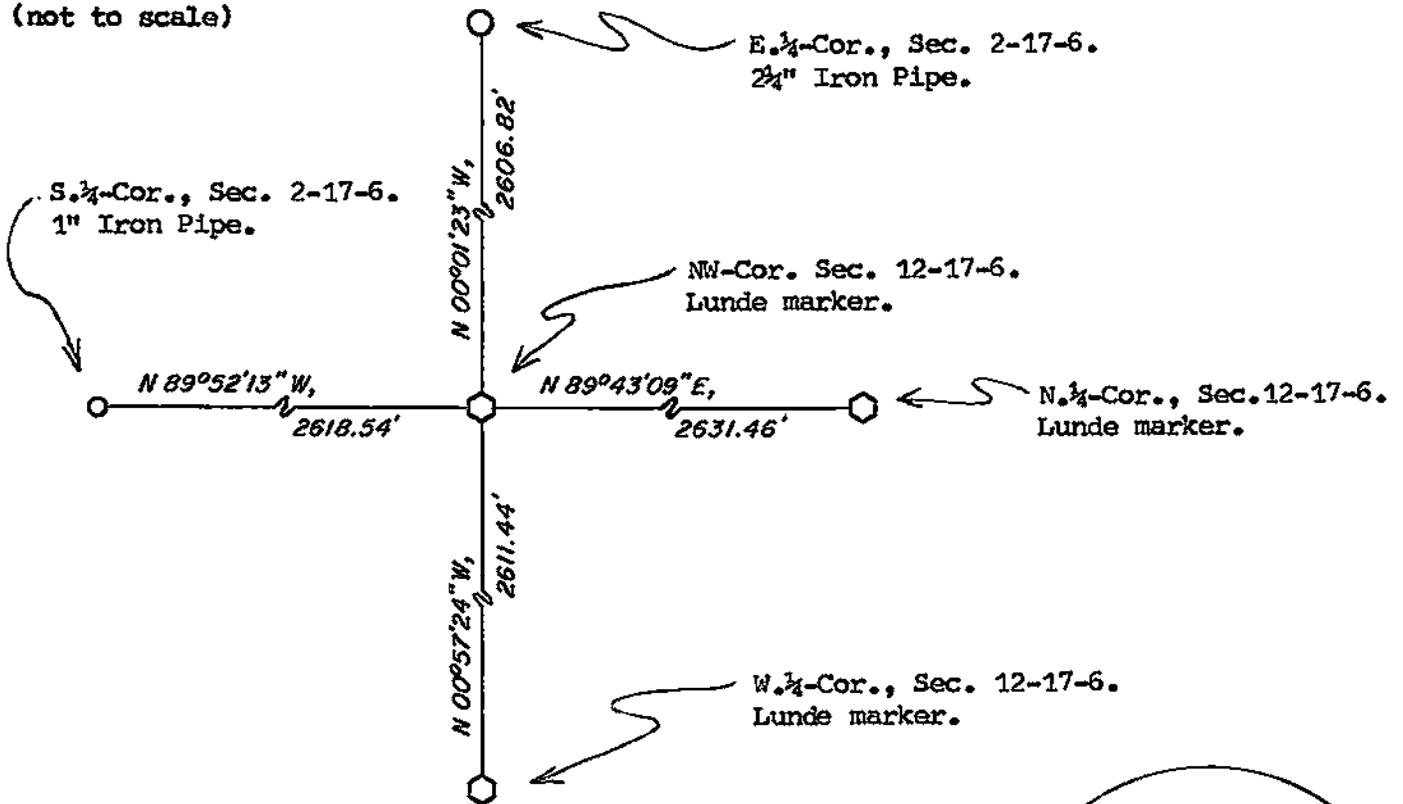

I, William C. Jung, County Surveyor
HEREBY CERTIFY THAT THE CORNER LOCATION SHOWN ON THIS RECORD
WAS DETERMINED BY ME OR UNDER MY DIRECTION AND CONTROL AND
THAT THIS U. S. PUBLIC LAND SURVEY MONUMENT RECORD IS CORRECT
AND COMPLETE TO THE BEST OF MY KNOWLEDGE AND BELIEF.

William C. Jung
Signature

2/7/95
Date

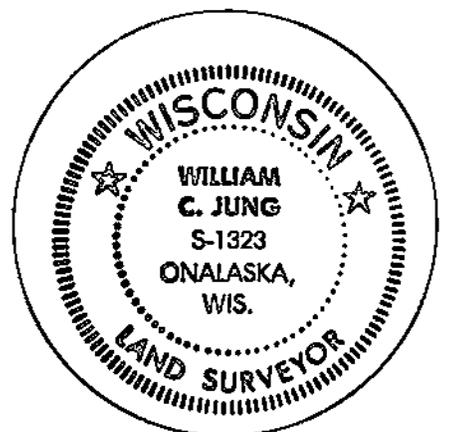

Seal