


21706020020

U. S. PUBLIC LAND SURVEY MONUMENT RECORD

SECTION 2 T 17 N, R 6 W, TOWN OF HAMILTON

LA CROSSE COUNTY

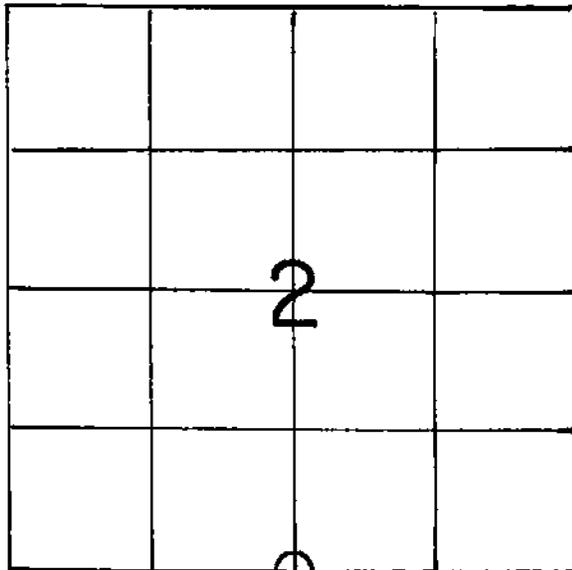

LOCATION OF LANDMARK

Crew: WILLIAM C. JUNG
PETER F. FOLLANSBEE

Date: 12/20 & 29/1994

Describe any record evidence, monument evidence, testimonial evidence or any other material evidence you considered and whether the monument was found or restored through acceptance of an obliterated evidence location.

I set this corner on line with the section corners and on line with the West line of the NE1/4 extended South, and monumented it with an iron pipe. I feel that this computed location best fits the evidence found in Section 2.

Describe or show any material discrepancy between the location of the restored corner and that of the corner previously restored or reestablished.

None Known.

WISCONSIN COORDINATE SYSTEM

North

East

Theta Angle

Horiz. Order

Vert. Order

TYPE OF LANDMARK

Set 1" x 30" Iron Pipe.

BEARINGS ARE REFERENCED TO

True North.

