


21706022020

U. S. PUBLIC LAND SURVEY MONUMENT RECORD

SECTION 2 T 17 N, R 6 W, TOWN OF HAMILTON

LA CROSSE COUNTY

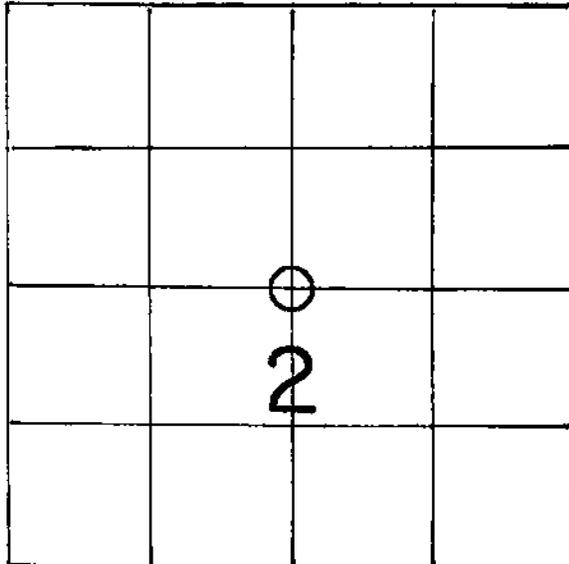

LOCATION OF LANDMARK

Crew: WILLIAM C. JUNG
PETER F. FOLLANSBEE

Date: 12/29/1994

Describe any record evidence, monument evidence, testimonial evidence or any other material evidence you considered and whether the monument was found or restored through acceptance of an obliterated evidence location.

I set this corner "by law", at the intersection of the 1/4 lines, and monumented it with an iron pipe.

Describe or show any material discrepancy between the location of the restored corner and that of the corner previously restored or reestablished.

None Known.

WISCONSIN COORDINATE SYSTEM

North

East

Theta Angle

Horiz. Order

Vert. Order

TYPE OF LANDMARK


Set 2 1/4" x 29" Iron Pipe.

BEARINGS ARE REFERENCED TO


True North.

RECORD OF DURABLE WITNESS MONUMENTS

NO	DESCRIPTION	MAGNETIC	
		BEARING	DISTANCE
1	Set P.K. Nail in NE-side 49" Maple	Northwesterly ±	Sl. = 34.11'
2	Center of telephone box	N 30° E	30.64 Ft.
3	Set P.K. Nail in S. side multi-trunk Maple	N 70° E	12.95 Ft.
4	Set P.K. Nail in S.-side 32" Maple	N 80° E	61.48 Ft.

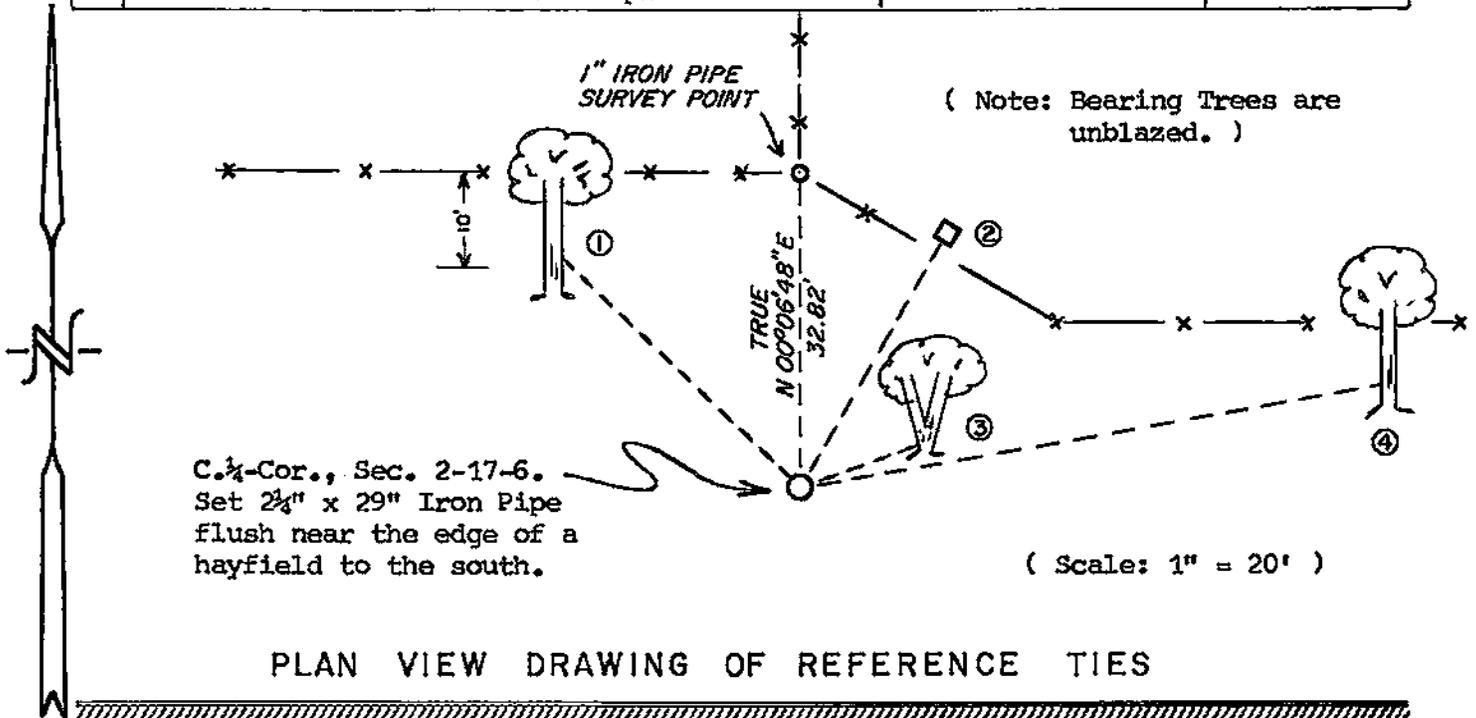

MAP SHOWING DISTANCE AND DIRECTION TO OTHER PUBLIC LAND SURVEY CORNERS USED FOR REESTABLISHING THE CORNER (not to scale)

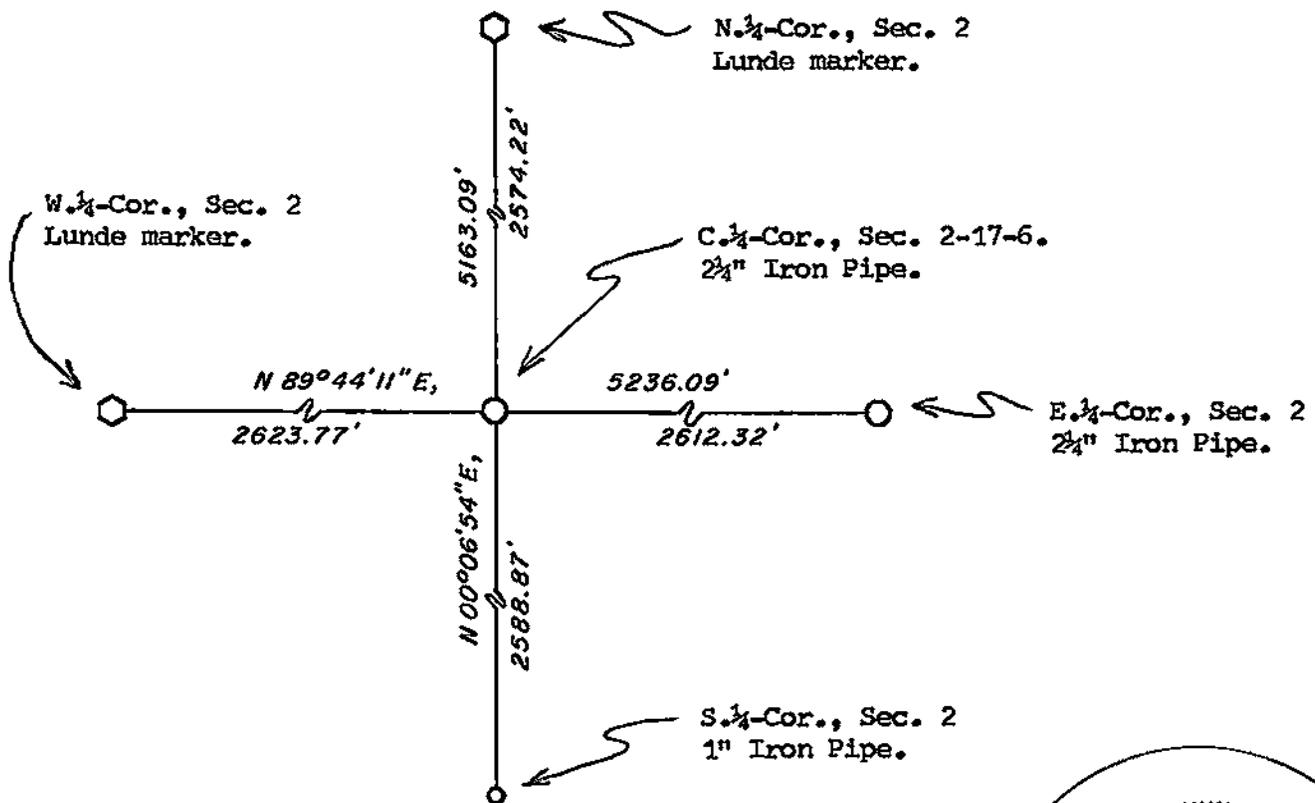

I, William C. Jung, County Surveyor
 HEREBY CERTIFY THAT THE CORNER LOCATION SHOWN ON THIS RECORD WAS DETERMINED BY ME OR UNDER MY DIRECTION AND CONTROL AND THAT THIS U. S. PUBLIC LAND SURVEY MONUMENT RECORD IS CORRECT AND COMPLETE TO THE BEST OF MY KNOWLEDGE AND BELIEF.

William C. Jung 2/10/95
 Signature Date



Seal