


21706030000

NO. 31

Zoning and Planning Department

**LA CROSSE COUNTY, WISCONSIN**

COURTHOUSE, LA CROSSE, WISCONSIN 54601

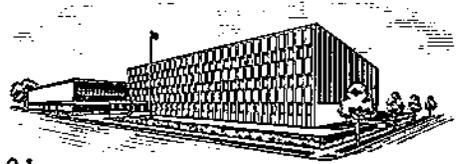

Telephone: 786-9722

To Whom It May Concern:

This is to certify that on 3/27/92 I removed the existing iron pipe at the Southeast Corner of Section 3-T17N-R6W, Town of Hamilton, and replaced it with a brass capped Lunde marker. The marker is flush. A vodka bottle with a brass shell casing is buried on the Southeast side of the Lunde. A sign and post are to the Southwest of the marker. Northwest of the marker is a 2" hickory which measures 2.78' from tree center to Lunde.

*William C. Jung*

William C. Jung  
R.L.S. 1323  
Deputy County Surveyor


April 10, 1992



# U. S. PUBLIC LAND SURVEY MONUMENT RECORD

SECTION 11 T 17 N, R 6 W, TOWN OF HAMILTON

LA CROSSE COUNTY

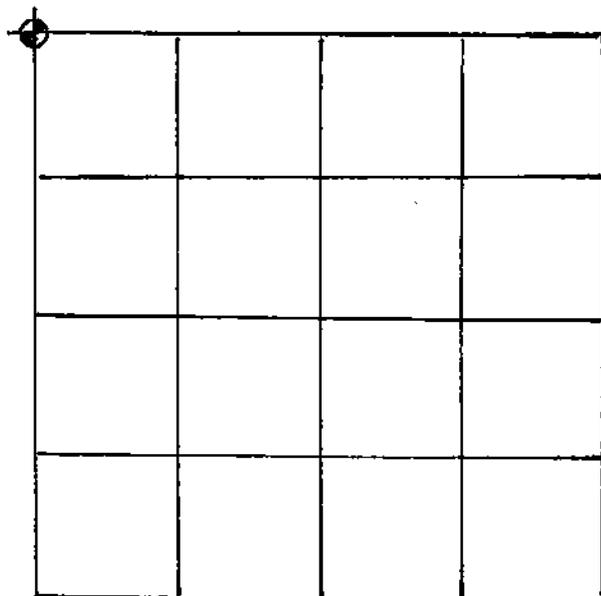

LOCATION OF LANDMARK

WISCONSIN COORDINATE SYSTEM
North
East
Theta Angle
Horiz. Order
Vert. Order
TYPE OF LANDMARK
<i>1" iron pipe</i>
BEARINGS ARE REFERENCED TO
<i>West line Sec. 11 between SW corner</i>
<i>and West 1/4 corner (S 0°-27'-08"E</i>


Describe any record evidence, monument evidence, testimonial evidence or any other material evidence you considered and whether the monument was found or restored through acceptance of an obliterated evidence location.

*We extended Hofmeister's West line from the SW corner of Sec. 11 through the West 1/4 corner and found a 1" pipe 0.64' off line and within 18' of the projected distance. The pipe was in the area of where local residents expected the corner to be. There were no fences or other monuments so we accepted the pipe as best evidence.*

Describe or show any material discrepancy between the location of the restored corner and that of the corner previously restored or reestablished.


RECORD OF DURABLE WITNESS MONUMENTS

NO	DESCRIPTION	BEARING	DISTANCE
1	Spike in 14" Hickory	N 87° 39' 10" W	137.60
2	Spike in 7" Hickory	S 64° 38' 05" W	38.22
3	Spike in 10" Hickory	S 42° 17' 37" W	22.51
4	Spike in 14" Hickory	N 61-27-15 E	80.45

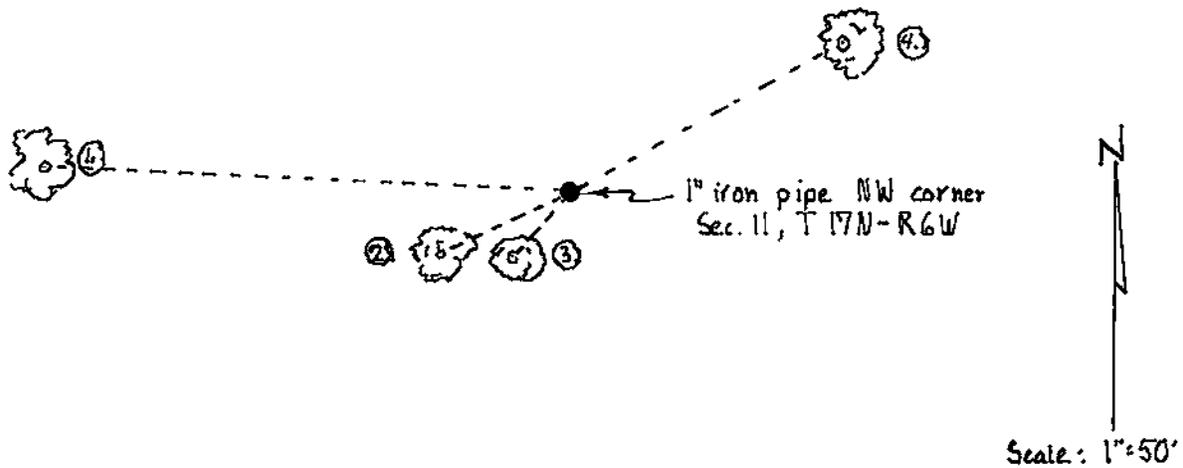

PLAN VIEW DRAWING OF REFERENCE TIES

MAP SHOWING DISTANCE AND DIRECTION TO OTHER PUBLIC LAND SURVEY CORNERS USED FOR REESTABLISHING THE CORNER

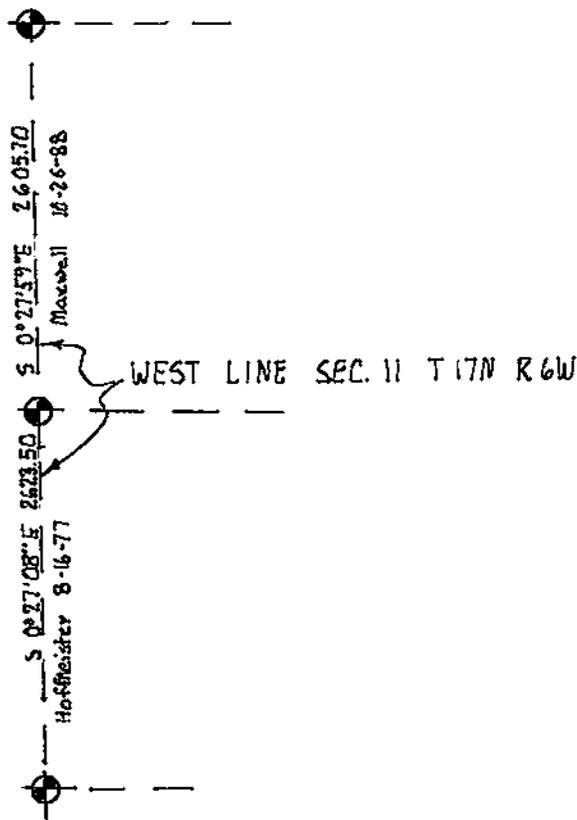

I, Stephen J. Solberg RLS 1846  
 HEREBY CERTIFY THAT THE CORNER LOCATION SHOWN ON THIS RECORD  
 WAS DETERMINED BY ME OR UNDER MY DIRECTION AND CONTROL AND  
 THAT THIS U. S. PUBLIC LAND SURVEY MONUMENT RECORD IS CORRECT  
 AND COMPLETE TO THE BEST OF MY KNOWLEDGE AND BELIEF.

Stephen J. Solberg 10-28-88  
 Signature Date



Seal