


21706030020

U. S. PUBLIC LAND SURVEY MONUMENT RECORD

SECTION 3 T 17 N, R 6 W, TOWN OF Hamilton

LA CROSSE COUNTY

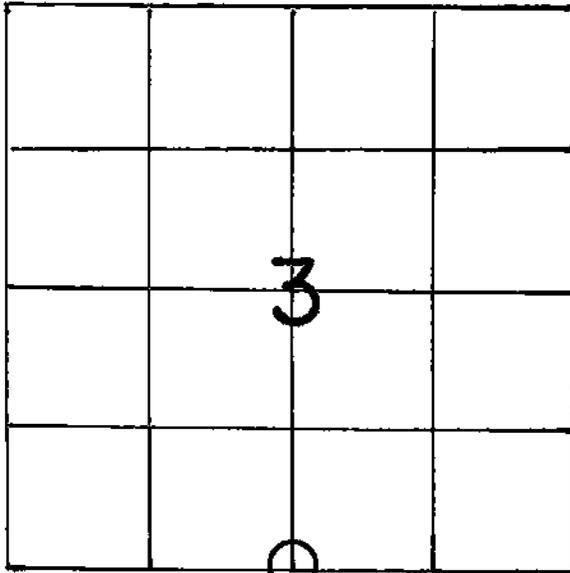

LOCATION OF LANDMARK

Crew: WILLIAM C. JUNG

PETER F. FOLLANSBEE

Date: 3/12/1992

Describe any record evidence, monument evidence, testimonial evidence or any other material evidence you considered and whether the monument was found or restored through acceptance of an obliterated evidence location.

I set this corner by single proportionate measurement. The computed corner does not fit the occupied corner as it falls 87' South of it. I followed the old line fence 1/2 mile to the West of the occupied corner. The first 1/4 mile appeared to be fairly straight, well maintained over the years, and very old as the wire went through the middle of old white oaks. It was obviously an "ancient" fence. The second 1/4 mile, which started from a well maintained (3) way fence corner with three tie posts, was not as well maintained, and meanders somewhat as it goes up and over the bluff. A study of the USGS map and Describe or show any material discrepancy between the location of the restored corner and that of the corner previously restored or reestablished.

(continued)

aerial photo also show that the occupied line and true line do not agree. The original notes indicate that when the random line was run the surveyors intersected at the post, quite a feat considering the terrain! Is it possible that they only ran the first 1/2 mile, never corrected, & "fudged" the notes, therefore accounting for the gross error? It's possible, but with the old County Surveyor records missing, I can't prove it. I have seen evidence of this in other sections though and believe that sometimes it was done. It is also interesting to note however that about 200' North of the occupied corner is a fence going to the East. By deed it should have been about 264'. This too would indicated that the occupied 1/4 corner is too far North.

WISCONSIN COORDINATE SYSTEM

North

East

Theta Angle

Horiz. Order

Vert. Order

TYPE OF LANDMARK


Set brass cap Lunde marker

BEARINGS ARE REFERENCED TO

Assumed North


RECORD OF DURABLE WITNESS MONUMENTS

NO	DESCRIPTION	MAGNETIC	
		BEARING	DISTANCE
1	Set P.K. Nail in E.-side 6" Hickory	S 28° W	22.81 Ft.
2	Set P.K. Nail in S.-side 7" Walnut?	N 61° W	10.19 Ft.
3	Set P.K. Nail in N.W.-side 4" dbl. W. Oak	S 60° E	19.38 Ft.
4	Set P.K. Nail in W.-side dbl. Bl. Oak	S 10° E	18.64 Ft.

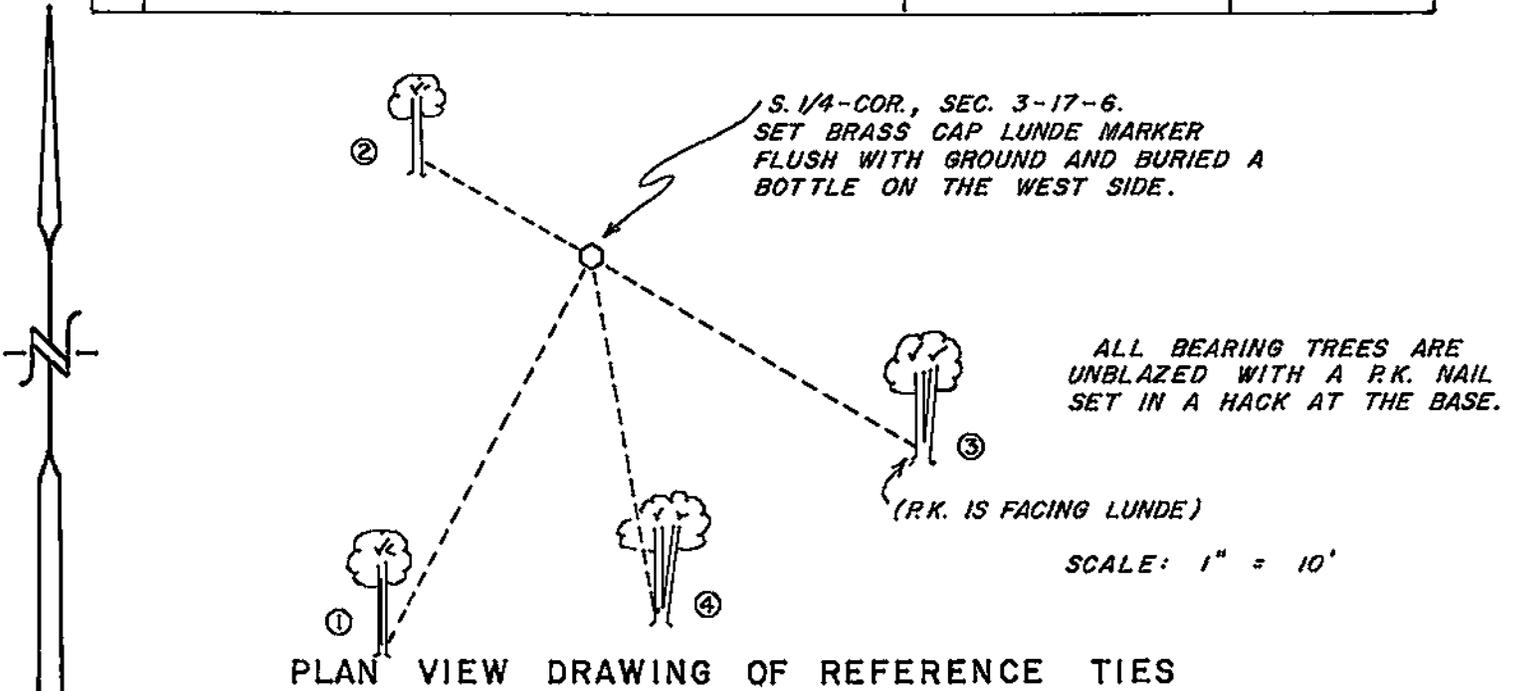

MAP SHOWING DISTANCE AND DIRECTION TO OTHER PUBLIC LAND SURVEY CORNERS USED FOR REESTABLISHING THE CORNER


(not to scale)

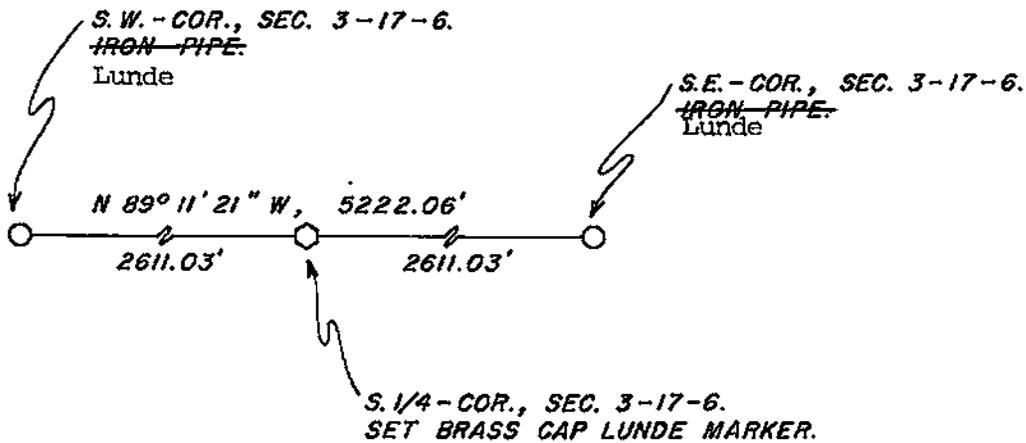

I, William C. Jung, Deputy County Surveyor
HEREBY CERTIFY THAT THE CORNER LOCATION SHOWN ON THIS RECORD
WAS DETERMINED BY ME OR UNDER MY DIRECTION AND CONTROL AND
THAT THIS U. S. PUBLIC LAND SURVEY MONUMENT RECORD IS CORRECT
AND COMPLETE TO THE BEST OF MY KNOWLEDGE AND BELIEF.

William C. Jung 3/12/92
Signature Date

Revised: 6/2/92 *wcj*

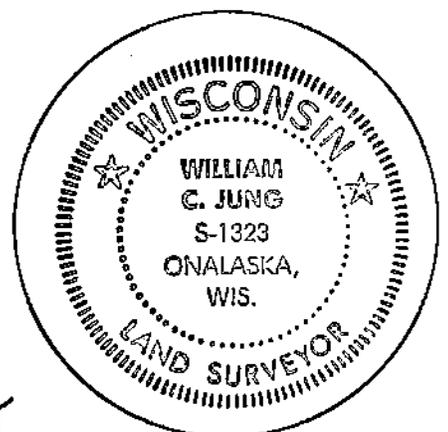

Seal