


U. S. PUBLIC LAND SURVEY MONUMENT RECORD

SECTION 3 T 17 N, R 6 W, TOWN OF Hamilton

LA CROSSE COUNTY

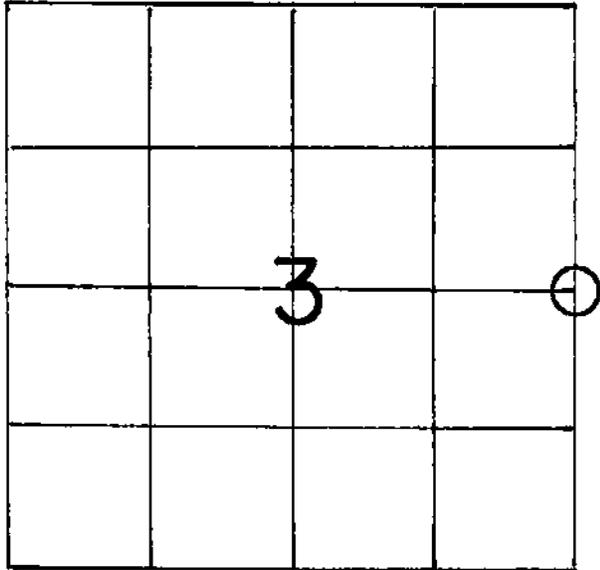

LOCATION OF LANDMARK

Crew: WILLIAM C. JUNG  
PETER F. FOLLANSBEE

Date: 1/13/1992

WISCONSIN COORDINATE SYSTEM

North

East

Theta Angle

Horiz. Order

Vert. Order

TYPE OF LANDMARK

Set ~~1" Iron Pipe~~ Lunde marker

BEARINGS ARE REFERENCED TO

Assumed North

Crew: William C. Jung  
Peter F. Follansbee

Date: May 12, 1992

Describe any record evidence, monument evidence, testimonial evidence or any other material evidence you considered and whether the monument was found or restored through acceptance of an obliterated evidence location.


I accepted the old occupied corner location as the best available evidence of the original government corner position and monumented it with ~~an iron pipe~~, a brass capped Lunde marker. An unrecorded 3/4"x21" bolt was found 3" to the West. A wine bottle with a shell casing was buried to the North of the Lunde. Also buried by the Lunde is a 1/2"x2"x23" steel bar. The bolt was removed.

Describe or show any material discrepancy between the location of the restored corner and that of the corner previously restored or reestablished.

None known

RECORD OF DURABLE WITNESS MONUMENTS


NO	DESCRIPTION	BEARING	DISTANCE
1	Set P.K. Nail in S.-side 11" W. Oak	Northwest ±	38.95 Ft.
2	Set P.K. Nail in N.-side 13" W. Oak	East ±	21.32 Ft.
3	Set P.K. Nail in S.W.-side 4" Oak w/sign	Southeast ±	6.97 Ft.
4	Set P.K. Nail in E.-side 17" W. Oak	South ±	23.07 Ft.

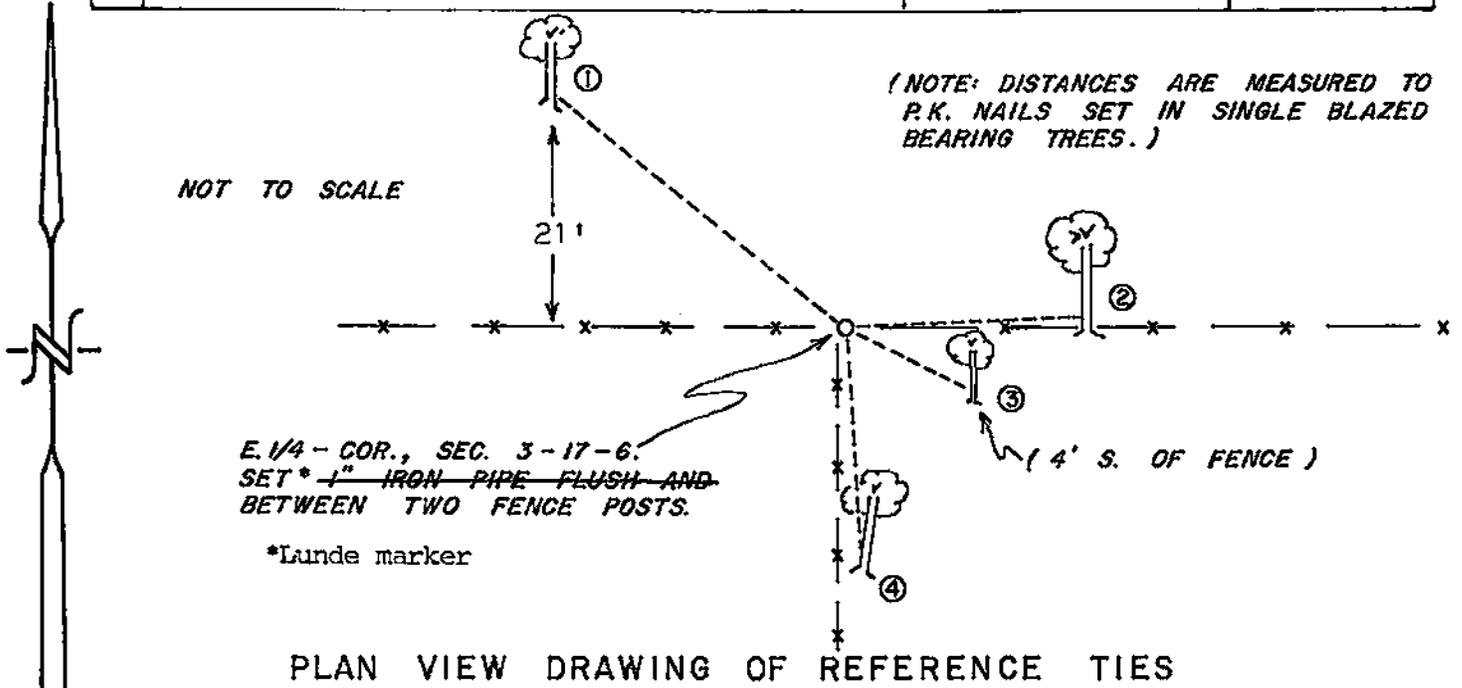

PLAN VIEW DRAWING OF REFERENCE TIES

MAP SHOWING DISTANCE AND DIRECTION TO OTHER PUBLIC LAND SURVEY CORNERS USED FOR REESTABLISHING THE CORNER

(not to scale)

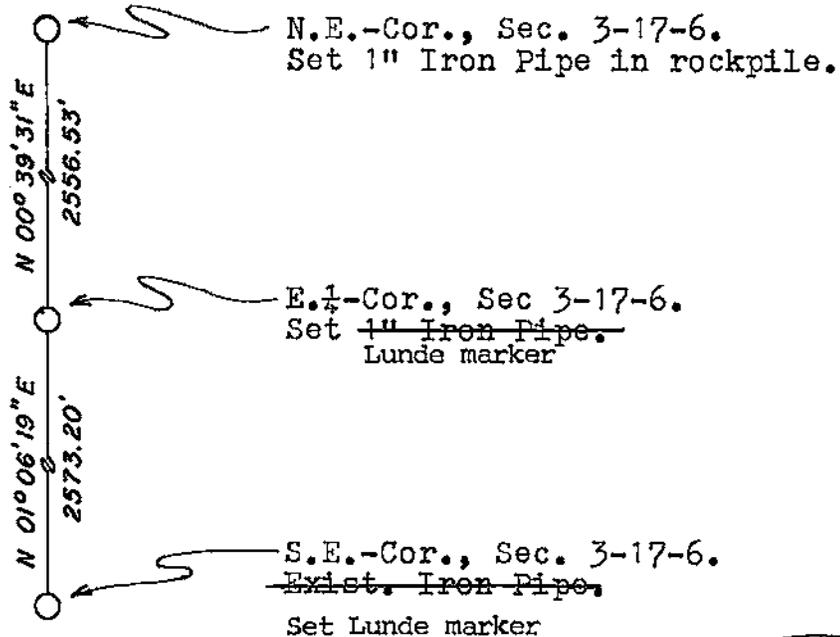


I, William C. Jung, Deputy County Surveyor  
 HEREBY CERTIFY THAT THE CORNER LOCATION SHOWN ON THIS RECORD  
 WAS DETERMINED BY ME OR UNDER MY DIRECTION AND CONTROL AND  
 THAT THIS U. S. PUBLIC LAND SURVEY MONUMENT RECORD IS CORRECT  
 AND COMPLETE TO THE BEST OF MY KNOWLEDGE AND BELIEF.

William C. Jung  
 Signature

March 11, 1992  
 Date

Revised: June 2, 1992

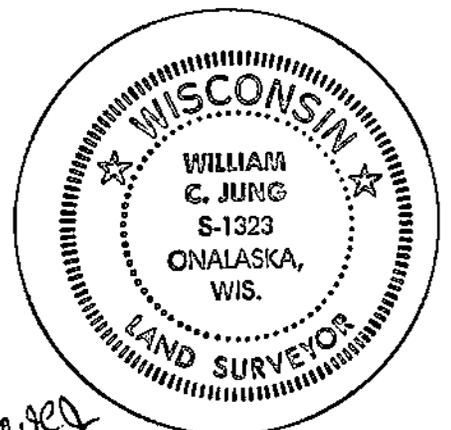

Seal