


U. S. PUBLIC LAND SURVEY MONUMENT RECORD

SECTION 3 T 17 N, R 6 W, TOWN OF HAMILTON
 LA CROSSE COUNTY

SECTION 3

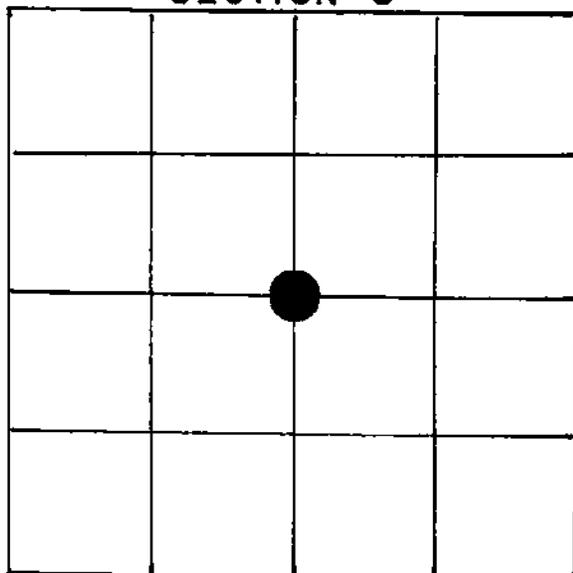

LOCATION OF LANDMARK

WISCONSIN COORDINATE SYSTEM

North

East

Theta Angle

Horiz. Order

Vert. Order

TYPE OF LANDMARK

Brass capped Lunde marker

BEARINGS ARE REFERENCED TO

Assumed

Crew: William C. Jung
 Peter F. Follansbee

Date: May 19, 1992

Describe any record evidence, monument evidence, testimonial evidence or any other material evidence you considered and whether the monument was found or restored through acceptance of an obliterated evidence location.

A brass capped Lunde marker was set at the intersection of the 1/4 lines.

Describe or show any material discrepancy between the location of the restored corner and that of the corner previously restored or reestablished.

None known.

