


U. S. PUBLIC LAND SURVEY MONUMENT RECORD

SECTION 9 T 17 N, R 6 W, TOWN OF HAMILTON

LA CROSSE COUNTY

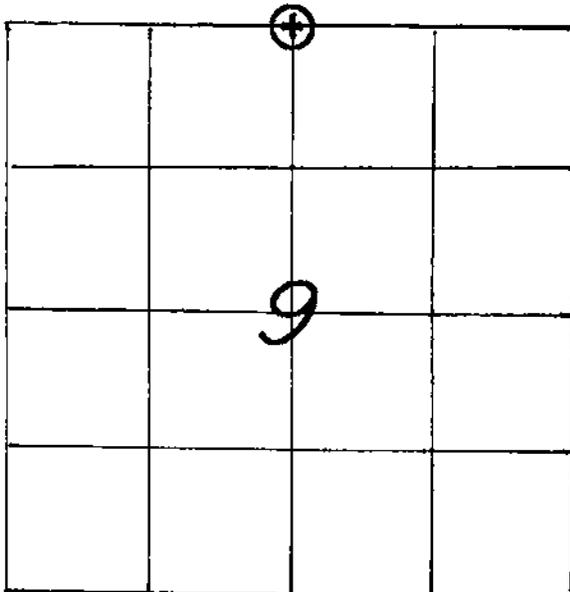

LOCATION OF LANDMARK

CREW: WILLIAM C. JUNG
 PETER F. FOLLANSBEE
 DATE: 6/27/2001

WISCONSIN COORDINATE SYSTEM	
North	720,363.773
East	1,678,389.293
Theta Angle	
Horiz. Order	
Vert. Order	
DATUM: 1983('91)	
TYPE OF LANDMARK	
3/4" x 30" IRON BAR WITH AN ALUMINUM CAP.	
BEARINGS ARE REFERENCED TO	
GRID NORTH AS PER SECTION DATA.	

Describe any record evidence, monument evidence, testimonial evidence or any other material evidence you considered and whether the monument was found or restored through acceptance of an obliterated evidence location.

I set an iron bar with a cap in a mound of rocks on line with a fence to the West of the old road and on line with another old fence to the South. I accepted this old occupied position as the best available evidence of the original government corner. I also found old fence to the North which if extended South would fall a few feet to the East of my corner. The fence to the North did not appear to be as good a fence. N12°E and 4.5' from the corner is a 12" oak. There is a scar on it that appears to be an overgrown blaze, not a logging scar or buck rub. Does this have anything to do with the stone that we found at the section corner to the West? Maybe.


Describe or show any material discrepancy between the location of the restored corner and that of the corner previously restored or reestablished.

NONE KNOWN.

RECORD OF DURABLE WITNESS MONUMENTS


MAGNETIC

NO	DESCRIPTION	BEARING	DISTANCE
1	SET A NAIL IN S.E.-SIDE OF A 13" WHITE OAK	S 19° W	32.92 FT.
2	SET A NAIL IN S.E.-SIDE OF A 4" WHITE OAK	S 51° W	5.85 FT.
3	SET A NAIL IN S.E.-SIDE OF A 7-1/2" OAK	N 32° E	14.95 FT.
4	SET A NAIL IN N.E.-SIDE OF A 9-1/2" OAK	S 60° E	29.38 FT.

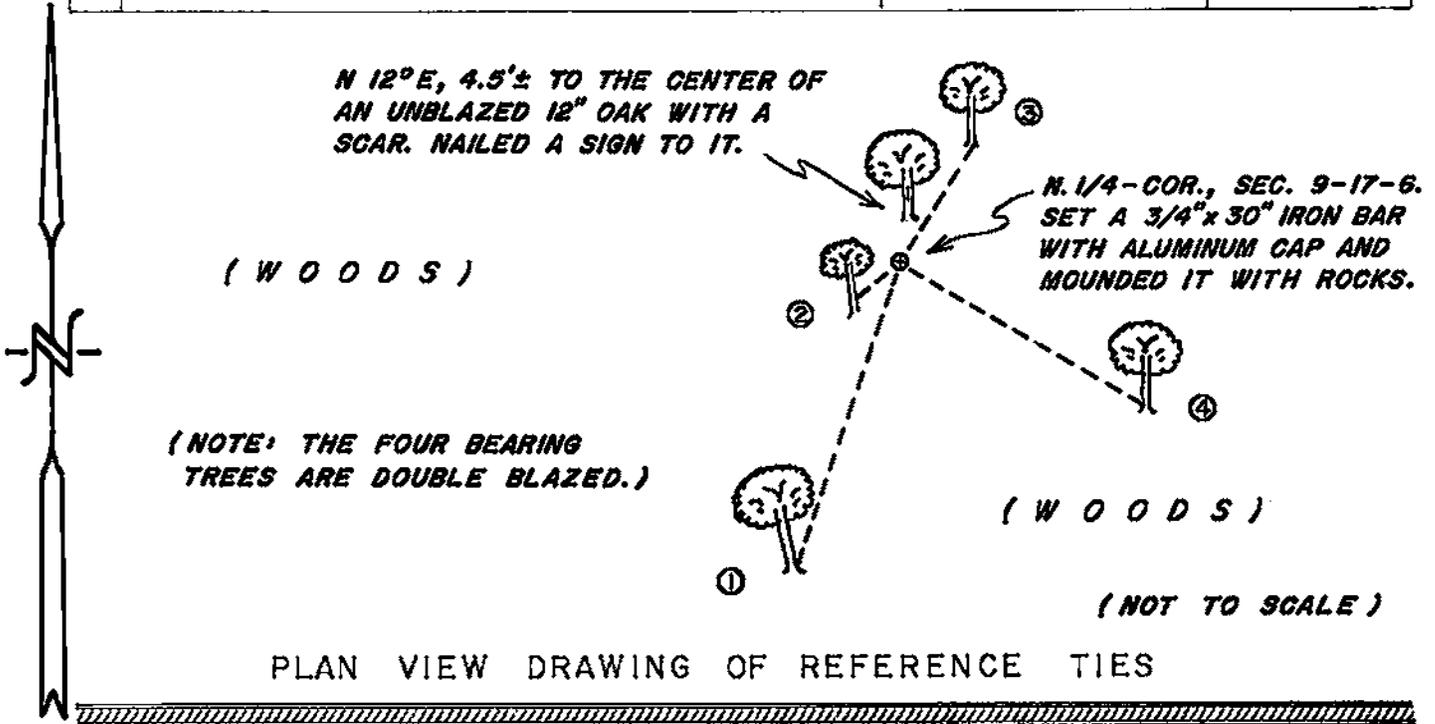

MAP SHOWING DISTANCE AND DIRECTION TO OTHER PUBLIC LAND SURVEY CORNERS USED FOR REESTABLISHING THE CORNER

(GRID BEARINGS & DISTANCES)
 (GRID FACTOR: 0.9999346)
 (NOT TO SCALE)

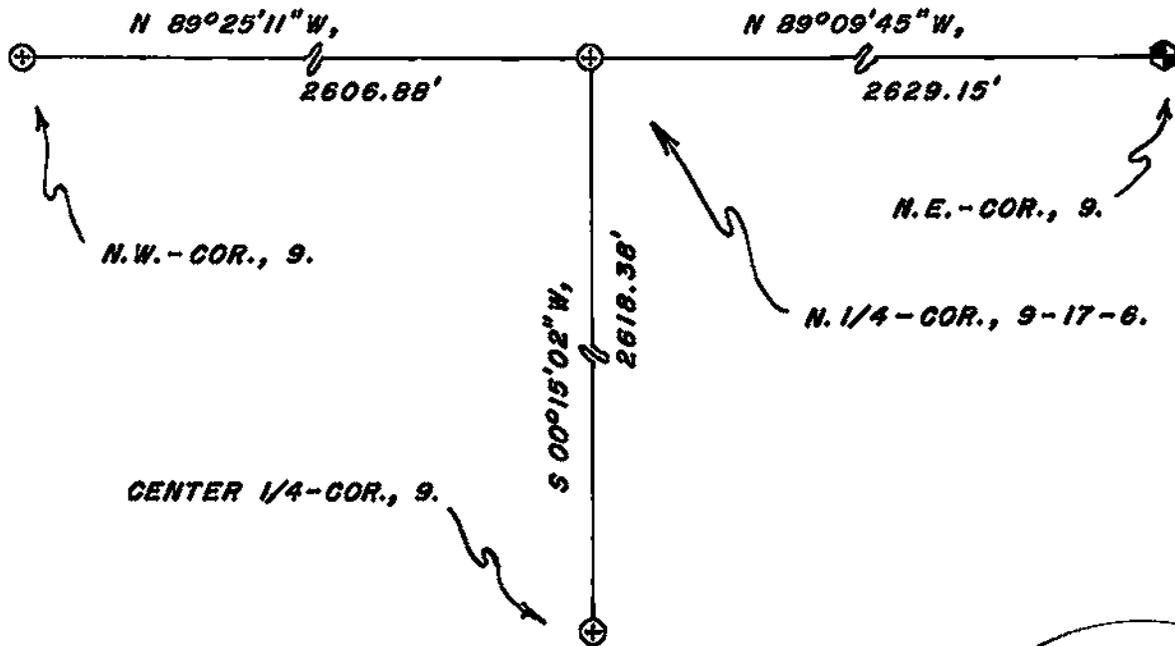

I, WILLIAM C. JUNG, COUNTY SURVEYOR
 HEREBY CERTIFY THAT THE CORNER LOCATION SHOWN ON THIS RECORD WAS DETERMINED BY ME OR UNDER MY DIRECTION AND CONTROL AND THAT THIS U. S. PUBLIC LAND SURVEY MONUMENT RECORD IS CORRECT AND COMPLETE TO THE BEST OF MY KNOWLEDGE AND BELIEF.

William C. Jung 11/16/01
 Signature Date

