


21706042000

U. S. PUBLIC LAND SURVEY MONUMENT RECORD

SECTION 3 T 17 N, R 6 W, TOWN OF Hamilton
 LA CROSSE COUNTY

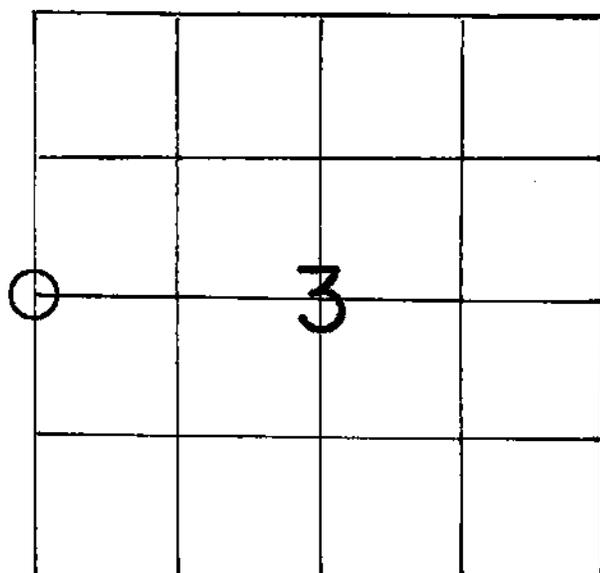

LOCATION OF LANDMARK

Crew: WILLIAM C. JUNG
 PETER F. FOLLANSBEE

Date: 3/12/1992

Describe any record evidence, monument evidence, testimonial evidence or any other material evidence you considered and whether the monument was found or restored through acceptance of an obliterated evidence location.

I set this corner by single proportionate measurement. The fences do not fit the computed corner. One of the McClintock brothers told me that he knew that the fence to the East was wrong since he put it in by himself without the help of a survey.

Describe or show any material discrepancy between the location of the restored corner and that of the corner previously restored or reestablished.

None known.

WISCONSIN COORDINATE SYSTEM

North

East

Theta Angle

Horiz. Order

Vert. Order

TYPE OF LANDMARK

Set ~~1 1/2~~ Iron Pipe Lunde marker

BEARINGS ARE REFERENCED TO

Assumed North


**RECORD OF DURABLE WITNESS MONUMENTS
MAGNETIC**

NO	DESCRIPTION	BEARING	DISTANCE
1	Set P.K. Nail in S.-side 15" W. Oak	N 88° W	14.36 Ft.
2	Set P.K. Nail in W.-side 8" Hickory	N 01° E	19.46 Ft.
3	Set P.K. Nail in N.-side 6" Hickory	N 89° E	11.32 Ft.
4	Set P.K. Nail in N.E.-side 8" Oak	S 15° E	9.92 Ft.

(NOTE: ALL BEARING TREES ARE DOUBLE BLAZED WITH P.K. NAILS SET IN HACKS IN THE SIDE OF THE TREES.)

W. 1/4-COR., SEC. 3-17-6.
SET 1" IRON PIPE WITH SIGN AND POST TO THE NORTH.

*brass capped Lunde marker with a wine bottle with shell casing buried on the South side

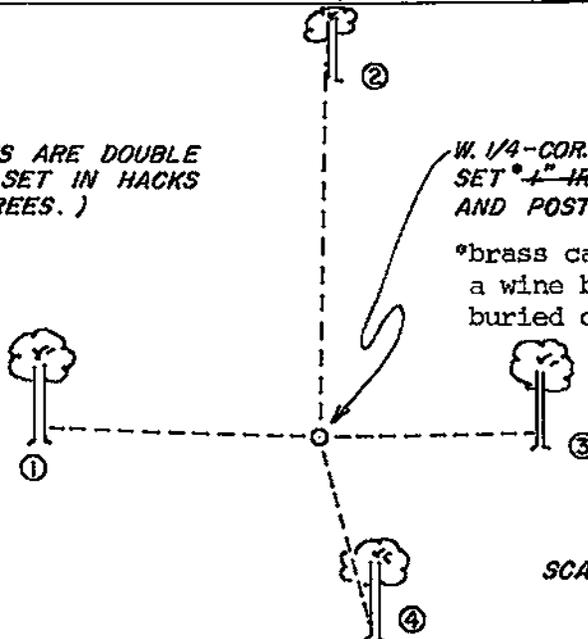


SCALE: 1" = 10'

PLAN VIEW DRAWING OF REFERENCE TIES

MAP SHOWING DISTANCE AND DIRECTION TO OTHER PUBLIC LAND SURVEY CORNERS USED FOR REESTABLISHING THE CORNER

(not to scale)

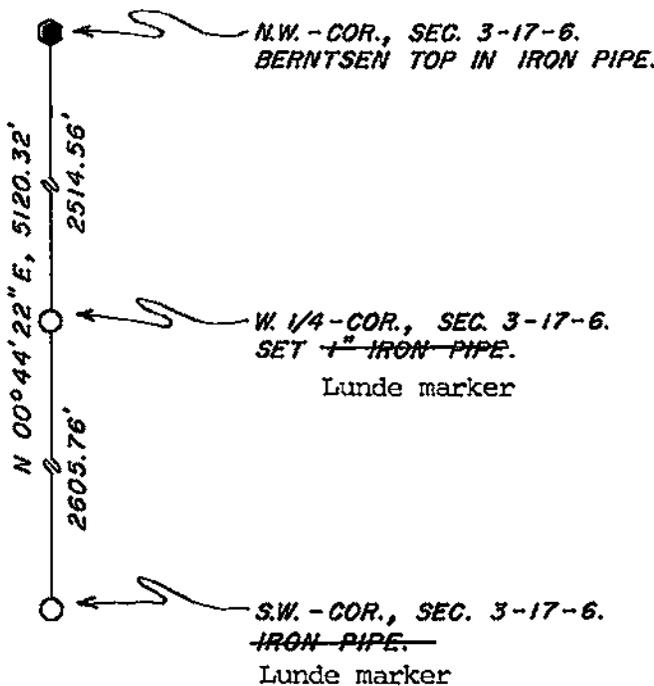


I, William C. Jung, Deputy County Surveyor
HEREBY CERTIFY THAT THE CORNER LOCATION SHOWN ON THIS RECORD
WAS DETERMINED BY ME OR UNDER MY DIRECTION AND CONTROL AND
THAT THIS U. S. PUBLIC LAND SURVEY MONUMENT RECORD IS CORRECT
AND COMPLETE TO THE BEST OF MY KNOWLEDGE AND BELIEF.

William C. Jung
Signature

3/12/92
Date

Revised: 6/2/92 *wey*

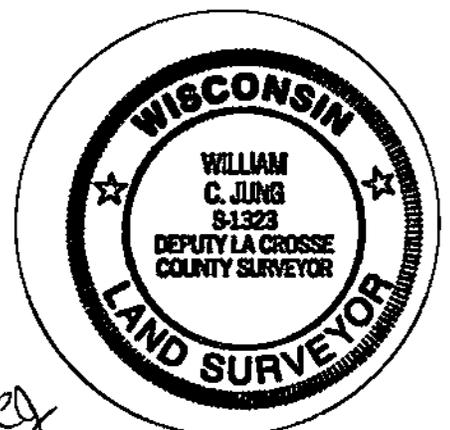

Seal