


21706050020

## U. S. PUBLIC LAND SURVEY MONUMENT RECORD

SECTION 5 T 17 N, R 6 W, TOWN OF HAMILTON

LA CROSSE COUNTY

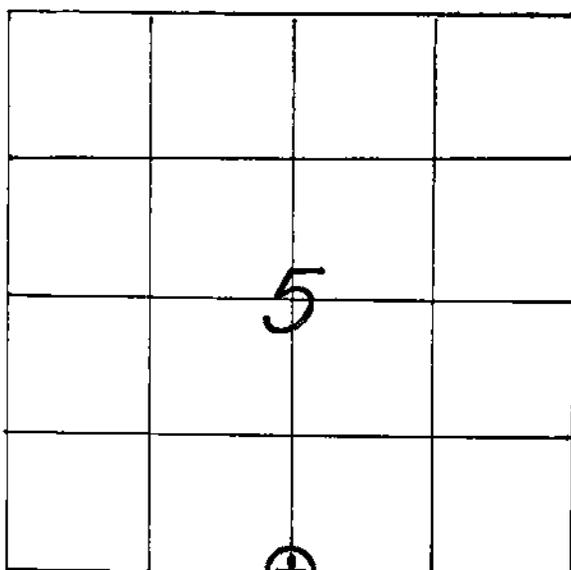

LOCATION OF LANDMARK

CREW: **WILLIAM C. JUNG**  
**PETER F. FOLLANSBEE**  
 DATE: **5/21/2003**

## WISCONSIN COORDINATE SYSTEM

North 720414.185

East 1673163.838

Theta Angle

Horiz. Order

Vert. Order

(83'91 datum)

## TYPE OF LANDMARK

**3/4" x 30" IRON BAR WITH ALUMINUM CAP.**

BEARINGS ARE REFERENCED TO

**GRID NORTH AS PER SECTION DATA.**

Describe any record evidence, monument evidence, testimonial evidence or any other material evidence you considered and whether the monument was found or restored through acceptance of an obliterated evidence location.

To the Northeast I found an old black oak stump over three feet across. I believe that this stump is from the original survey. As such I set the corner using the original calls from the stump. I set an iron bar with a cap at the corner, piled stones around it, and also set a sign and post.

Describe or show any material discrepancy between the location of the restored corner and that of the corner previously restored or reestablished.

**NONE KNOWN.**

