


21706052000

U. S. PUBLIC LAND SURVEY MONUMENT RECORD

SECTION 5 T 17 N, R 6 W, TOWN OF HAMILTON

LA CROSSE COUNTY

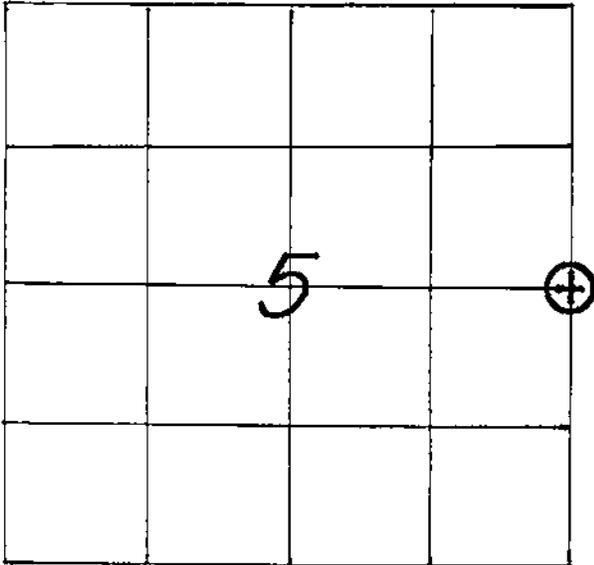

LOCATION OF LANDMARK

CREW: **WILLIAM G. JUNG**
PETER F. FOLLANSBEE
 DATE: **5/13/2003**

WISCONSIN COORDINATE SYSTEM	
North	722,987.597
East	1,675,813.249
Theta Angle	
Horiz. Order	
Vert. Order	
(83'91 datum)	
TYPE OF LANDMARK	
3/4" x 30" IRON BAR WITH ALUMINUM CAP.	
BEARINGS ARE REFERENCED TO	
GRID NORTH.	

Describe any record evidence, monument evidence, testimonial evidence or any other material evidence you considered and whether the monument was found or restored through acceptance of an obliterated evidence location.

I accepted the occupied corner position as the best available evidence of the old corner. Based on the evidence, I believe that a surveyor, after the original government survey, attempted to set this corner at the single proportionate position as the entire mile is over a chain short. I set an iron bar with a cap at the corner, piled stones around it, and also set a sign and post. I also found a large field stone just to the East

Describe or show any material discrepancy between the location of the restored of the corner. corner and that of the corner previously restored or reestablished.

NONE KNOWN.

