


21706072000

U. S. PUBLIC LAND SURVEY MONUMENT RECORD

SECTION 8 T 17 N, R 6 W, TOWN OF HAMILTON
 LA CROSSE COUNTY

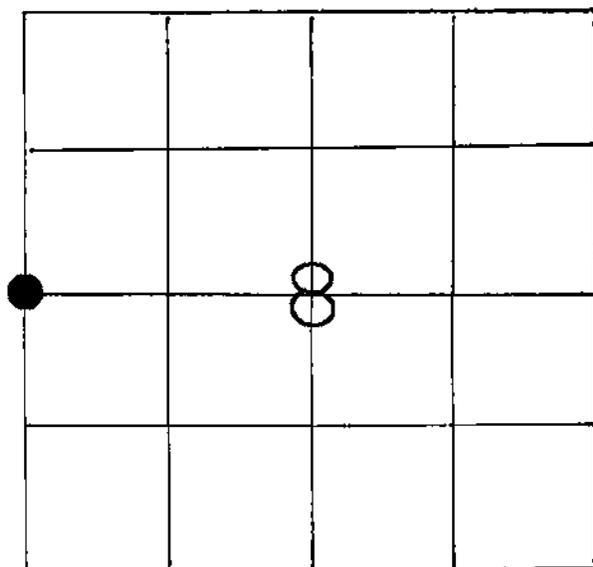

LOCATION OF LANDMARK

CREW: WILLIAM C. JUNG
 PETER F. FOLLANSBEE
 DATE: 11/04/1998

| |
|--|
| WISCONSIN COORDINATE SYSTEM |
| North |
| East |
| Theta Angle |
| Horiz. Order |
| Vert. Order |
| TYPE OF LANDMARK |
| 3/4" x 30" IRON BAR WITH AN ALUMINUM CAP |
| BEARINGS ARE REFERENCED TO |
| ASSUMED NORTH. |

Describe any record evidence, monument evidence, testimonial evidence or any other material evidence you considered and whether the monument was found or restored through acceptance of an obliterated evidence location.

I set this corner "by law", by single proportionate measurement, and monumented the corner with an iron bar with a cap.


Describe or show any material discrepancy between the location of the restored corner and that of the corner previously restored or reestablished.

None known.

RECORD OF DURABLE WITNESS MONUMENTS


MAGNETIC

| NO | DESCRIPTION | BEARING | DISTANCE |
|----|--|---------|-----------|
| 1 | SET A NAIL IN THE N.E.-SIDE 14" WHITE OAK | N 64° W | 28.28 FT. |
| 2 | SET A NAIL IN THE S.W.-SIDE 8" WHITE OAK | N 45° W | 27.27 FT. |
| 3 | SET A NAIL IN THE N.W.-SIDE 5-1/2" HICKORY | N 34° E | 12.48 FT. |
| 4 | SET A NAIL IN THE S.-SIDE 9" WHITE OAK | N 79° E | 41.31 FT. |

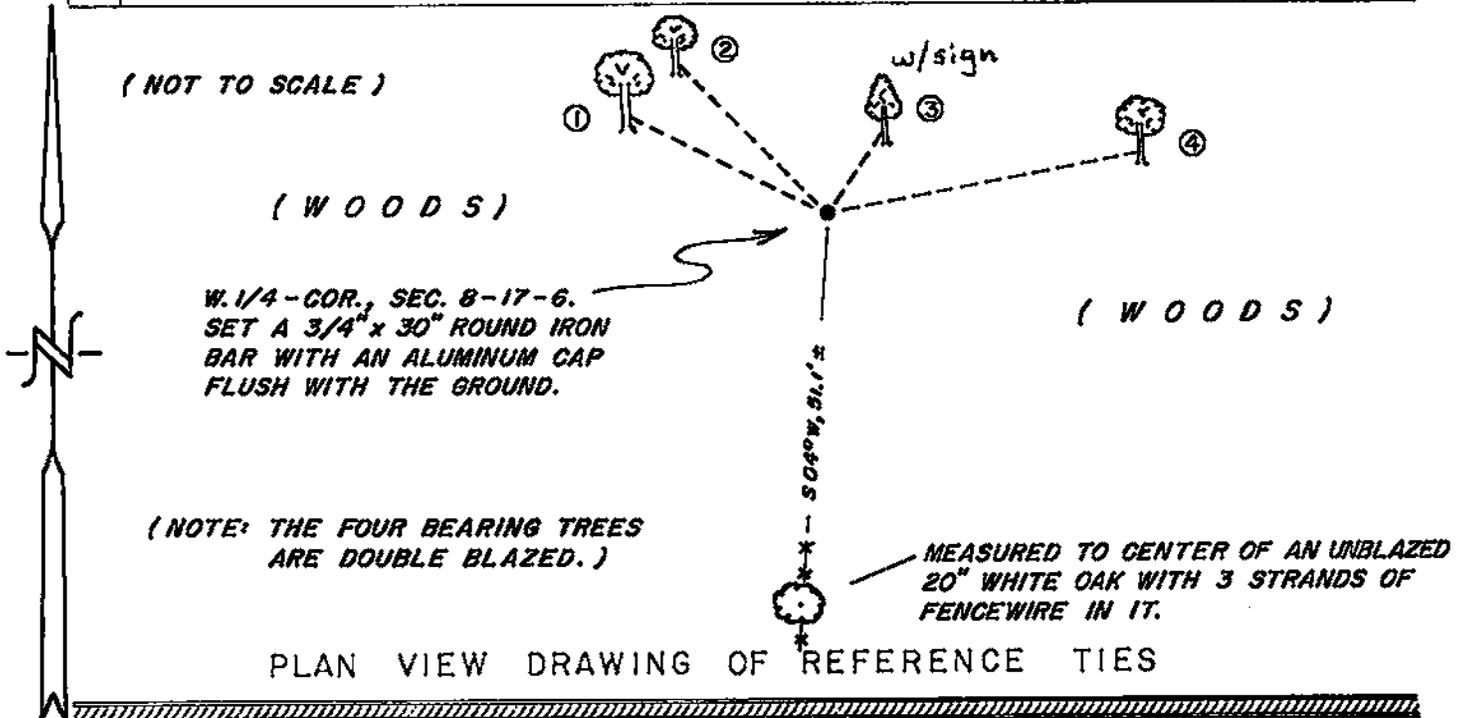


MAP SHOWING DISTANCE AND DIRECTION TO OTHER PUBLIC LAND SURVEY CORNERS USED FOR REESTABLISHING THE CORNER

(not to scale)

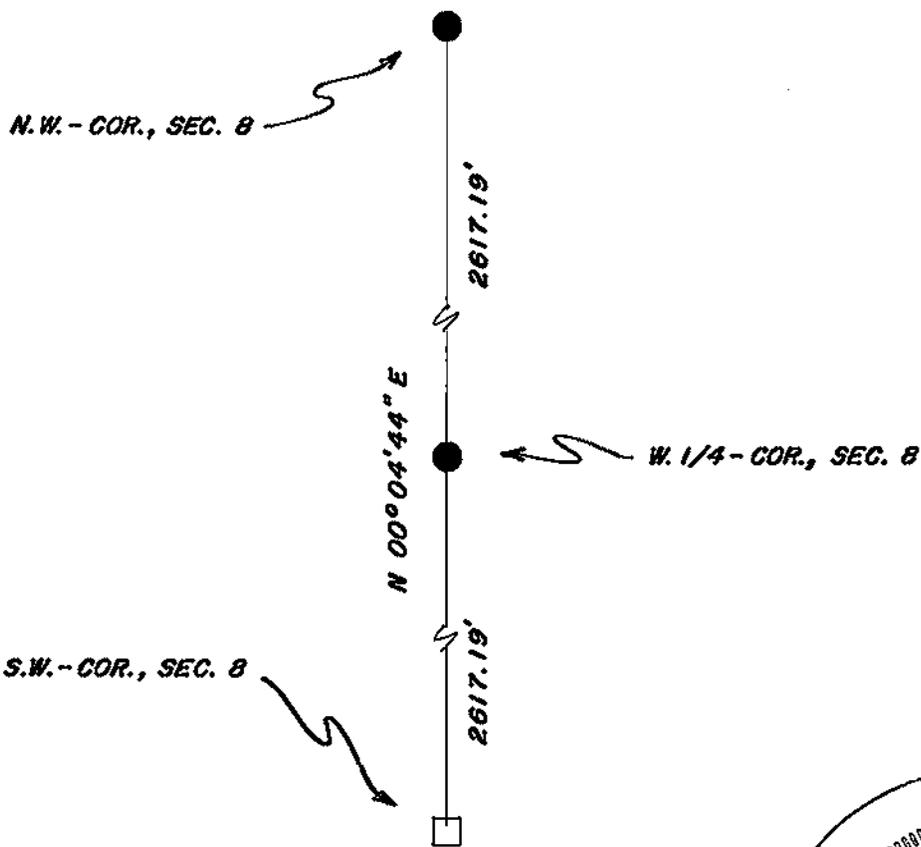

I, WILLIAM C. JUNG, COUNTY SURVEYOR
HEREBY CERTIFY THAT THE CORNER LOCATION SHOWN ON THIS RECORD WAS DETERMINED BY ME OR UNDER MY DIRECTION AND CONTROL AND THAT THIS U. S. PUBLIC LAND SURVEY MONUMENT RECORD IS CORRECT AND COMPLETE TO THE BEST OF MY KNOWLEDGE AND BELIEF.

William C. Jung 12 / 31 / 98
Signature Date

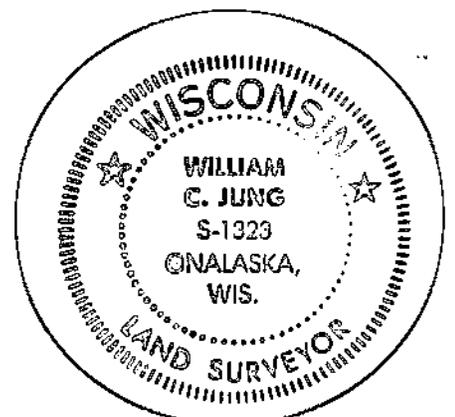

Seal