


21706080020

## U. S. PUBLIC LAND SURVEY MONUMENT RECORD

SECTION 8 T 17 N, R 6 W, TOWN OF HAMILTON  
 LA CROSSE COUNTY

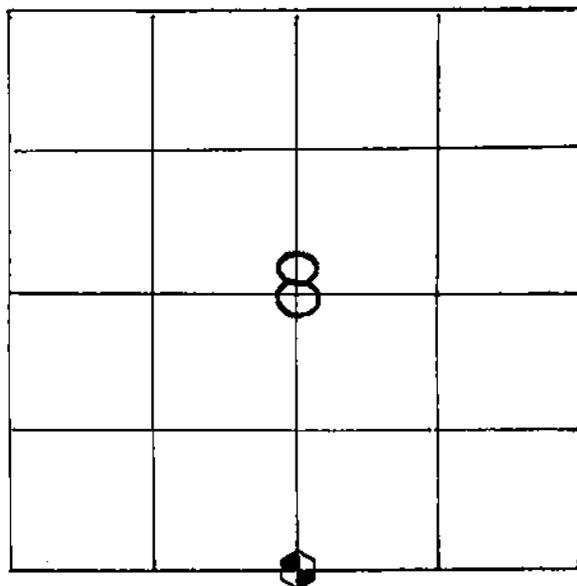

LOCATION OF LANDMARK

CREW: WILLIAM C. JUNG  
 PETER F. FOLLANSBEE  
 DATE: 11/04/1998

## WISCONSIN COORDINATE SYSTEM

North

East

Theta Angle

Horiz. Order

Vert. Order

## TYPE OF LANDMARK

BRASS CAP LUNDE MARKER.

BEARINGS ARE REFERENCED TO

ASSUMED NORTH.

Describe any record evidence, monument evidence, testimonial evidence or any other material evidence you considered and whether the monument was found or restored through acceptance of an obliterated evidence location.


In April of 1996 I set an iron pipe at this corner as a temporary corner only. The pipe was set at the occupied corner. In June of that year Randy Connell used this pipe as the corner in a survey to the East. Connell used the pipe as the corner since it fit both in distance and alignment. My measurements this year show the corner fits very well also to the West. I therefore accepted the old occupied corner as the best available evidence of the original government corner position. Describe or show any material discrepancy between the location of the restored and corner and that of the corner previously restored or reestablished. replaced the pipe with a Lunde.

None known.

RECORD OF DURABLE WITNESS MONUMENTS


MAGNETIC

NO	DESCRIPTION	BEARING	DISTANCE
1	SET A NAIL IN THE S.E.-SIDE 7-1/2" WHITE OAK	S 64° W	7.85 FT.
2	SET A NAIL IN THE S.-SIDE 19" WHITE OAK	S 89° E	20.84 FT.
3	SET A NAIL IN THE N.E.-SIDE DOUBLE OAK	S 29° E	25.30 FT.
4	SET A NAIL IN THE N.W.-SIDE 8-1/2" OAK	S 19° W	26.45 FT.

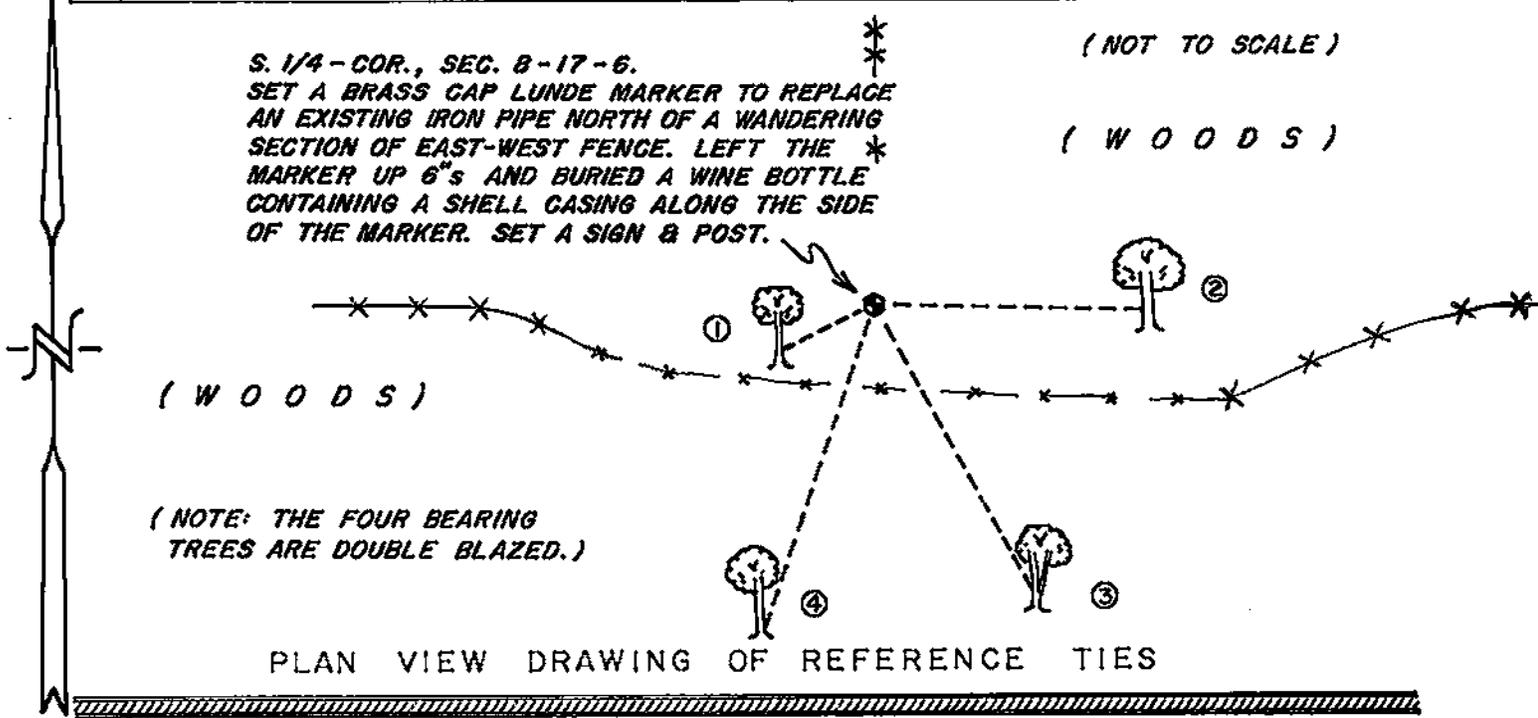

MAP SHOWING DISTANCE AND DIRECTION TO OTHER PUBLIC LAND SURVEY CORNERS USED FOR REESTABLISHING THE CORNER

(not to scale)

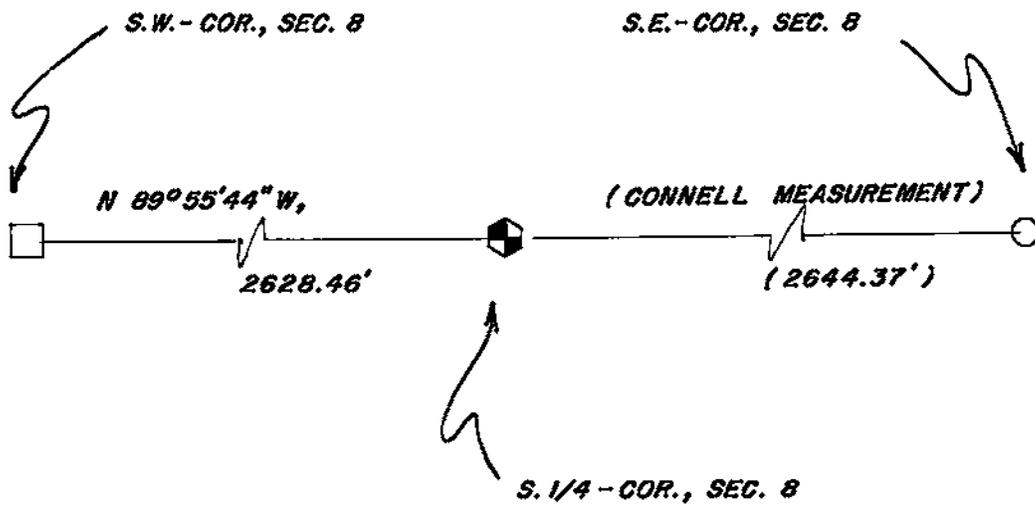

I, WILLIAM C. JUNG, COUNTY SURVEYOR  
 HEREBY CERTIFY THAT THE CORNER LOCATION SHOWN ON THIS RECORD WAS DETERMINED BY ME OR UNDER MY DIRECTION AND CONTROL AND THAT THIS U. S. PUBLIC LAND SURVEY MONUMENT RECORD IS CORRECT AND COMPLETE TO THE BEST OF MY KNOWLEDGE AND BELIEF.

William C. Jung 12/31/98  
 Signature Date



Seal