


## U. S. PUBLIC LAND SURVEY MONUMENT RECORD

SECTION 9 T 17 N, R 6 W, TOWN OF HAMILTON

LA CROSSE COUNTY

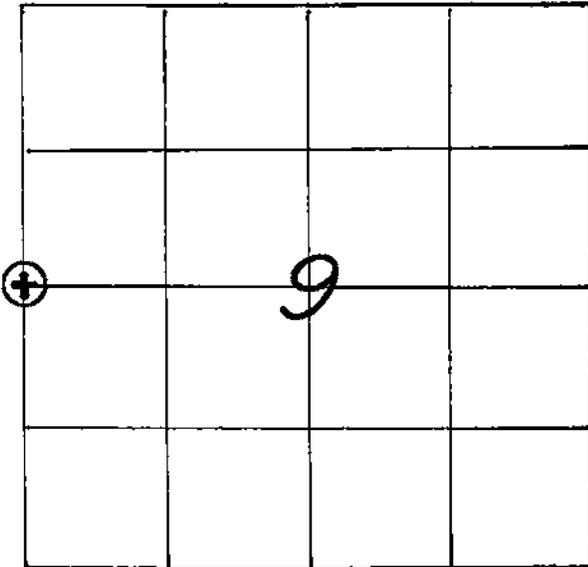

LOCATION OF LANDMARK

CREW: WILLIAM G. JUNG

PETER F. FOLLANSBEE

DATE: 7/02/2001

## WISCONSIN COORDINATE SYSTEM

North 717,776.084

East 1,675,755.260

Theta Angle

Horiz. Order

Vert. Order

DATUM: 1983('91)

TYPE OF LANDMARK

3/4" x 30" IRON BAR WITH ALUMINUM CAP.

BEARINGS ARE REFERENCED TO

GRID NORTH AS PER SECTION DATA.

Describe any record evidence, monument evidence, testimonial evidence or any other material evidence you considered and whether the monument was found or restored through acceptance of an obliterated evidence location.

I set an iron bar with a cap on line with fence remnants to the North and fence remnants to the East. I accepted this old occupied position as the best available evidence of the original government corner. S24°W and 25.5' from the corner I found an old dead oak, still upright but "petrified". It fits the original government call for distance pretty good, but not for bearing.

Describe or show any material discrepancy between the location of the restored corner and that of the corner previously restored or reestablished.

**NONE KNOWN.**

