


## U. S. PUBLIC LAND SURVEY MONUMENT RECORD

SECTION 10 T 17 N, R 6 W, TOWN OF HAMILTON

LA CROSSE COUNTY

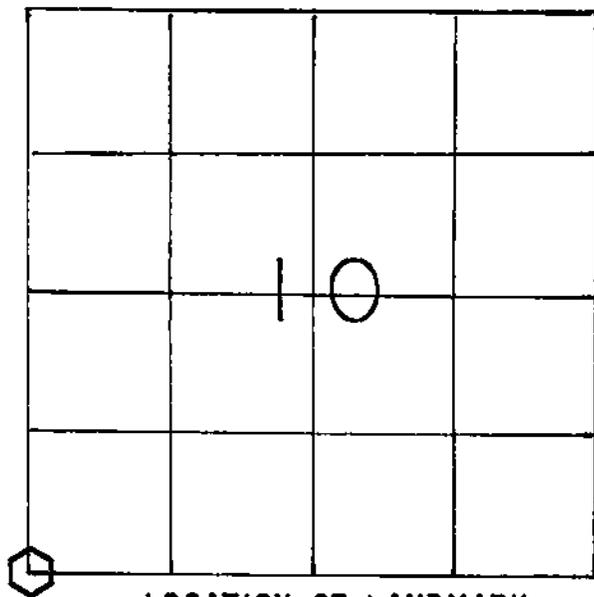

LOCATION OF LANDMARK

Crew: William C. Jung  
Peter F. Follansbee

Date: March 27, 1992

Describe any record evidence, monument evidence, testimonial evidence or any other material evidence you considered and whether the monument was found or restored through acceptance of an obliterated evidence location.

I set an iron bar at this corner in 1980. I removed my old iron bar and replaced it with a Lunde marker. Also removed was my old iron bar survey point to the West. A whiskey bottle with a shell casing was buried to the SW of the Lunde, and sign and post were set to the South. My iron bar had been used as the corner in a number of surveys since I set it back in 1980.

Describe or show any material discrepancy between the location of the restored corner and that of the corner previously restored or reestablished.

None known.

## WISCONSIN COORDINATE SYSTEM

North

East

Theta Angle

Horiz. Order

Vert. Order


## TYPE OF LANDMARK

Brass capped Lunde marker

BEARINGS ARE REFERENCED TO

RECORD OF DURABLE WITNESS MONUMENTS

NO	DESCRIPTION	Magnetic	DISTANCE
		BEARING	
1	10" aspen	N21°W	Rec.=22.06
2	30" white oak	S50°W	Rec.=63.96
3	22" white oak	S12°W	Rec. slope = 63.54
4	P.K. nail in unblazed white oak, C=10.6'	S 4°W	slope=75.85

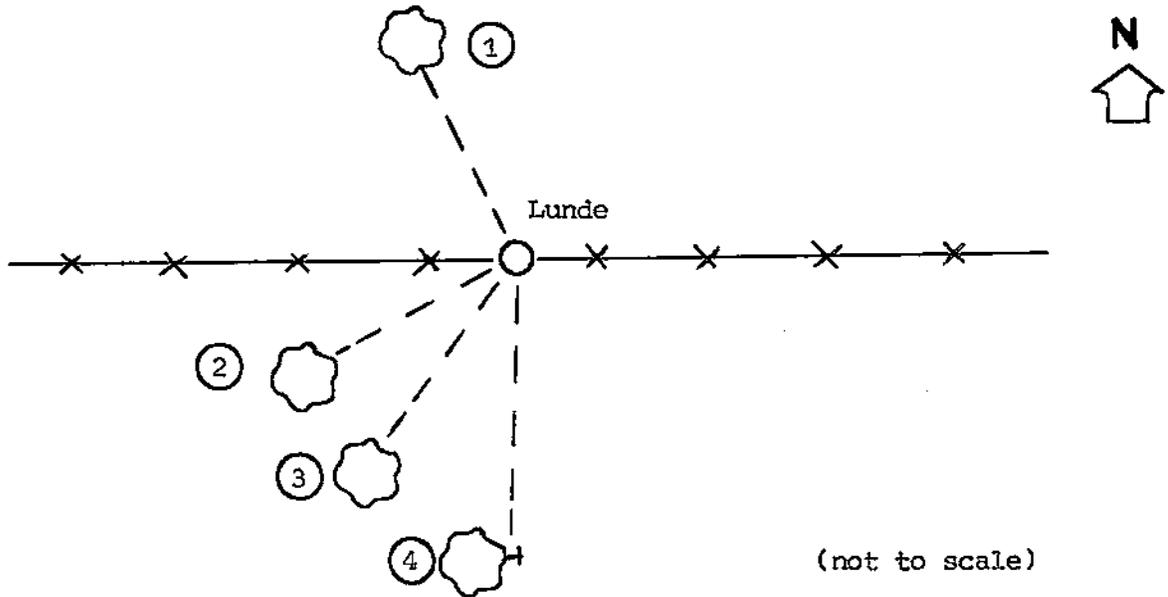


PLAN VIEW DRAWING OF REFERENCE TIES

MAP SHOWING DISTANCE AND DIRECTION TO OTHER PUBLIC LAND SURVEY CORNERS USED FOR REESTABLISHING THE CORNER

No further section work was done by me at this time.

I, William C. Jung, Deputy County Surveyor,  
 HEREBY CERTIFY THAT THE CORNER LOCATION SHOWN ON THIS RECORD  
 WAS DETERMINED BY ME OR UNDER MY DIRECTION AND CONTROL AND  
 THAT THIS U. S. PUBLIC LAND SURVEY MONUMENT RECORD IS CORRECT  
 AND COMPLETE TO THE BEST OF MY KNOWLEDGE AND BELIEF.

William C. Jung Signature  
 June 4, 1992 Date

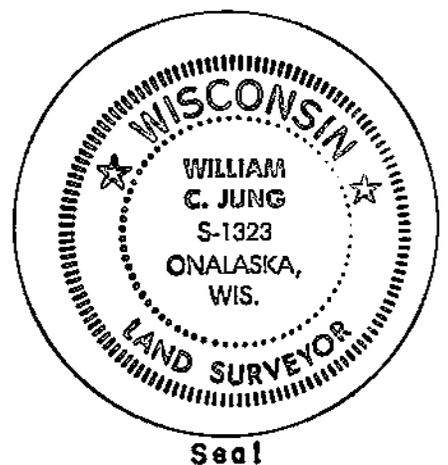


Seal

**SURVEY MONUMENT LOCATION RECORD**

LANDMARK  BENCHMARK  
 CORNER IDENTITY: S.W. Corner  
 STATE PLANE COORDINATE: N: \_\_\_\_\_  
 ZONE: \_\_\_\_\_ E: \_\_\_\_\_  
 ELEVATION - (FEET): \_\_\_\_\_ DATUM: \_\_\_\_\_  
 THETA ANGLE: \_\_\_\_\_ WEATHER: Overcast  
 DATE OF SURVEY: 2/19/80 TEMPERATURE: +38 °F  
 SURVEY PARTY: Bill Jung, Carl Pietz

SECTION 10  
 TOWN 17N  
 RANGE 6W  
 FOUND [ ] SET  RE-SET [ ]  
Hamilton  
 (CITY, VILLAGE, TOWN)


FILE NO. 2810  
 H.A. Sime and Associates

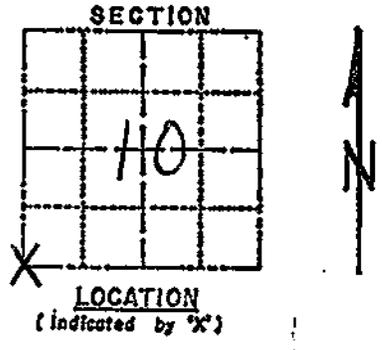

**BASIS FOR MONUMENT LOCATION:**  
 (DESCRIBE METHOD OF SURVEY AND CORNER AUTHENTICATION)

SEAL:


Projected the occupied section line (to the North) South until it intersected the occupied East-West section line. Fits the field evidence North and East very well. No old bearing trees or monuments were found. Accepted the occupied field evidence as the best evidence of the original corner.

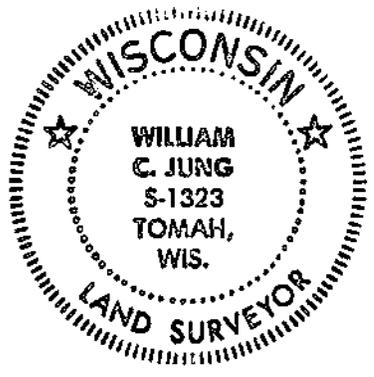

CERTIFIED CORRECT:  
William C. Jung  
 Registered Land Surveyor  
 DATE: 2/19/80

**TIE SKETCH:** SHOW MINIMUM OF THREE (3) HORIZONTAL TIE DISTANCES TO FIXED WITNESS MONUMENTS. DESCRIBE ALL MONUMENTS FOUND OR SET.

(All bearing trees are double blazed, with a nail and cap also in each tree. Measurements were taken to the N.E.C.)

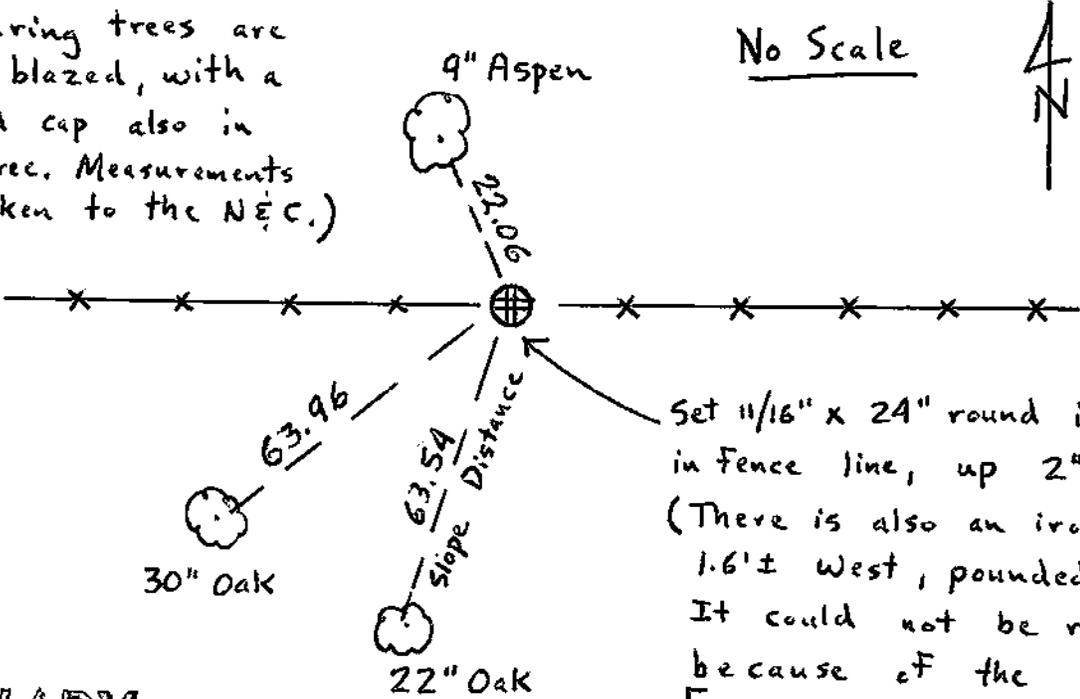

No Scale

Set 1/16" x 24" round iron bar in fence line, up 2" ±. (There is also an iron bar 1.6' ± west, pounded down. It could not be removed because of the frost.) [My first survey point.]

**PRELIMINARY**