


U. S. PUBLIC LAND SURVEY MONUMENT RECORD

SECTION 9 T 17 N, R 6 W, TOWN OF HAMILTON

LA CROSSE COUNTY

LAT: 43°57'24.18524 N, (.002m)
 LON: 91°06'06.56610 W, (.001m)
 ELL. HGT IN M: (283.824m), (.002m)

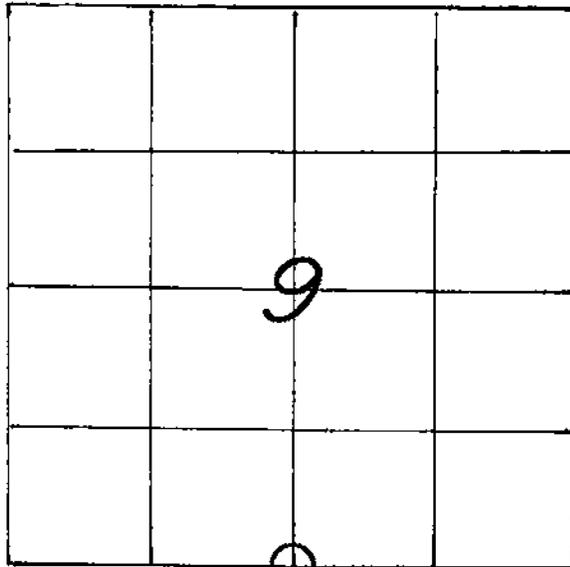

LOCATION OF LANDMARK

CREW: **WILLIAM C. JUNG**
PETER F. FOLLANSBEE
 DATE: **7/03/2001**

WISCONSIN COORDINATE SYSTEM	
North	715,097.953
East	1,678,366.278
Theta Angle	
Horiz. Order	
Vert. Order	
DATUM:	1983('91)
TYPE OF LANDMARK	
3/4" x 30" IRON BAR WITH ALUMINUM CAP.	
BEARINGS ARE REFERENCED TO	
GRID NORTH AS PER SECTION DATA.	

Describe any record evidence, monument evidence, testimonial evidence or any other material evidence you considered and whether the monument was found or restored through acceptance of an obliterated evidence location.


I found a very old fence corner at this location. The cor. post was large and leaning to the North. The fences to the North and East are still upright. To the Southeast of this fence corner I found a large old rotted stump, much of it being a pile of sawdust. I believe that this is an original bearing tree stump. I set an iron bar with cap at the corner by measuring from the stump. This lines up with the fence to the North and falls 2' Northwest of the corner post position if it were plumbed up. The monument fits the occupied corner very well.

Describe or show any material discrepancy between the location of the restored corner and that of the corner previously restored or reestablished.

In 1989 the late Clayton Connell measured the South line of Section 9. I match his overall mile very well. I don't believe that he ever went to the South 1/4 corner. It appears that he computed it out on paper only by single proportionate measurement. I do not agree with this.


RECORD OF DURABLE WITNESS MONUMENTS
MAGNETIC

NO	DESCRIPTION	BEARING	DISTANCE
1	SET A P.K. NAIL IN N.W.-SIDE OF A 10" HICKORY	S 25° W	29.67 FT.
2	SET A P.K. NAIL IN N.W.-SIDE OF A 21" WHITE OAK	N 14° E	21.31 FT.
3	SET A P.K. NAIL IN S.E.-SIDE OF A 20" OAK	N 60° E	SLOPE = 28.52'
4	SET A P.K. NAIL IN N.-SIDE OF A 20" OAK	S 84° E	14.32 FT.

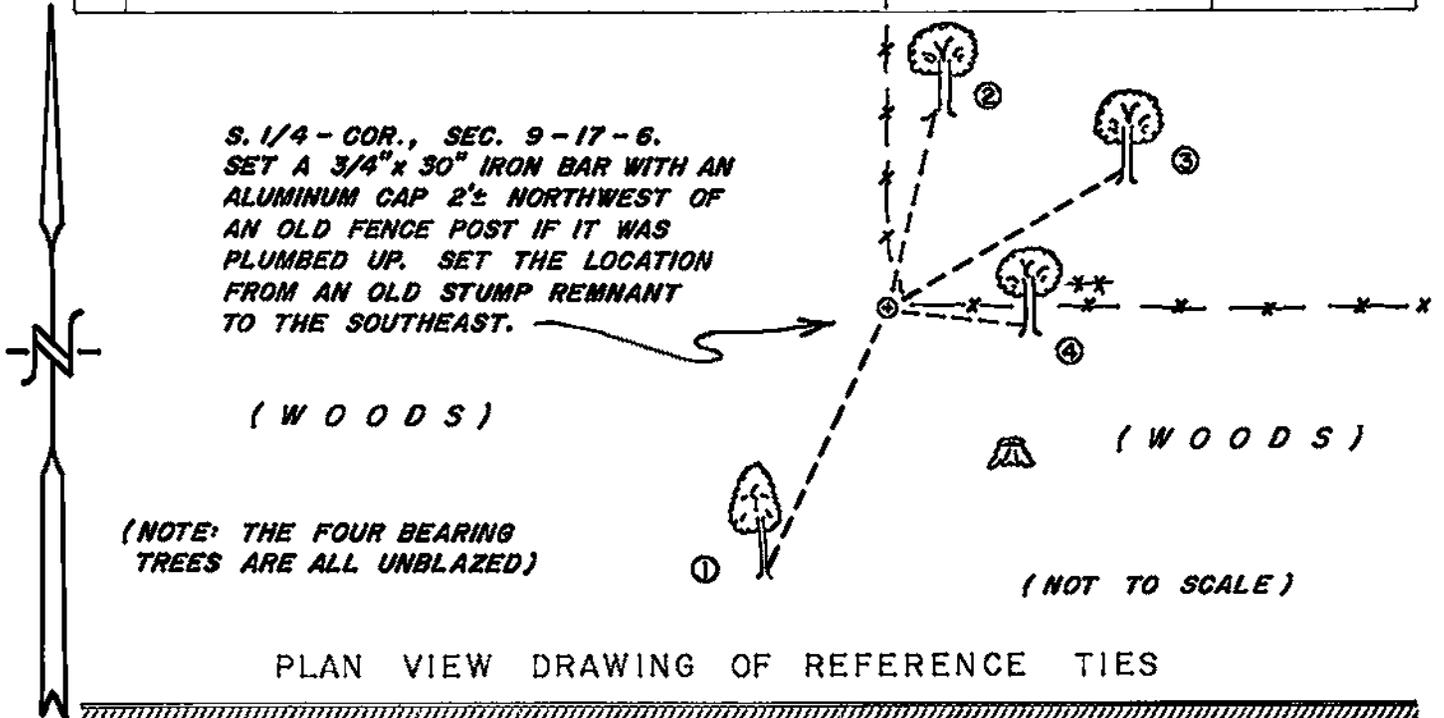

MAP SHOWING DISTANCE AND DIRECTION TO OTHER PUBLIC LAND SURVEY CORNERS USED FOR REESTABLISHING THE CORNER

(GRID BEARINGS AND DISTANCES)
(GRID FACTOR: 0.9999346)
(NOT TO SCALE)

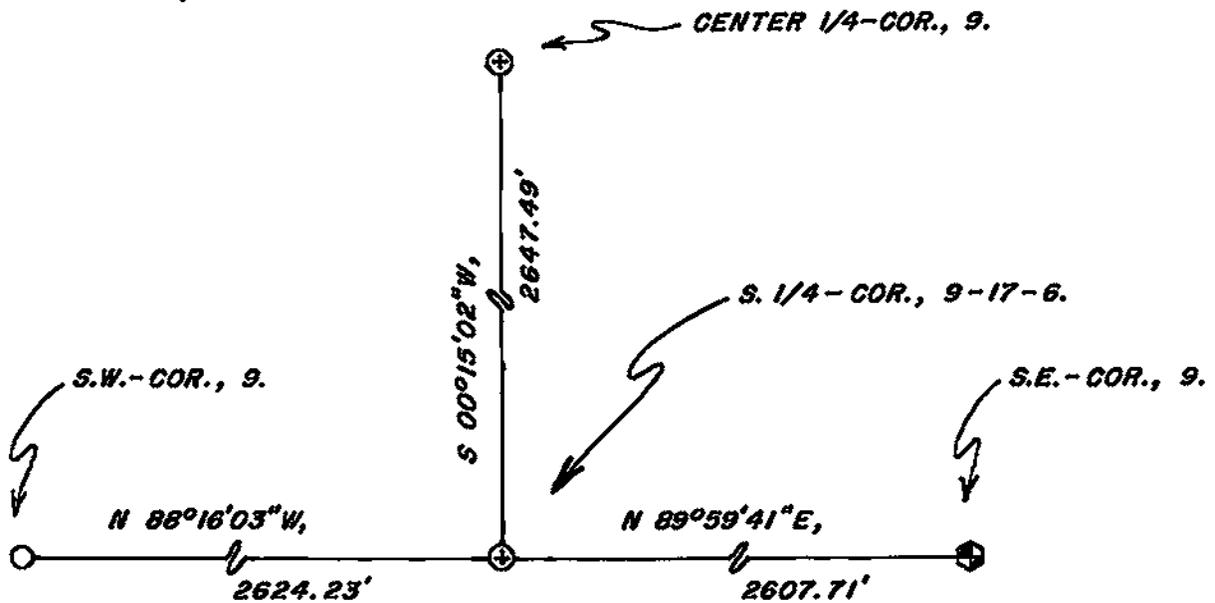

I, WILLIAM C. JUNG, COUNTY SURVEYOR
HEREBY CERTIFY THAT THE CORNER LOCATION SHOWN ON THIS RECORD WAS DETERMINED BY ME OR UNDER MY DIRECTION AND CONTROL AND THAT THIS U. S. PUBLIC LAND SURVEY MONUMENT RECORD IS CORRECT AND COMPLETE TO THE BEST OF MY KNOWLEDGE AND BELIEF.

William C. Jung 11/16/01
Signature Date



Seal