


21706092000

## U. S. PUBLIC LAND SURVEY MONUMENT RECORD

SECTION 10 T 17 N, R 6 W, TOWN OF Hamilton

LA CROSSE COUNTY

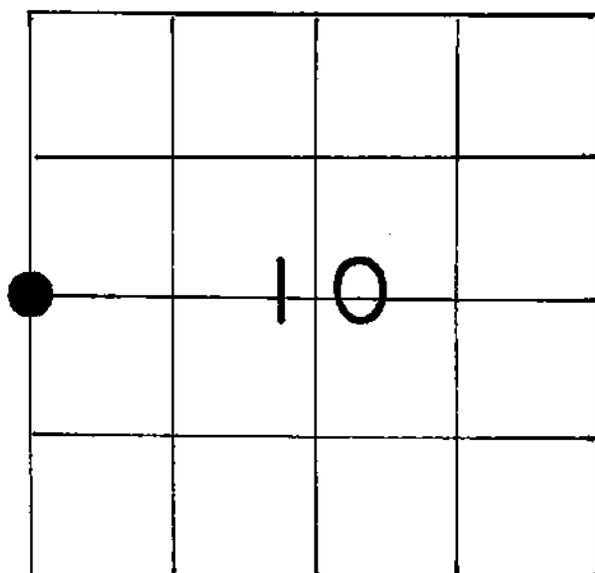

LOCATION OF LANDMARK

Crew: William C. Jung  
Peter F. Follansbee

Date: 9/27/90

Describe any record evidence, monument evidence, testimonial evidence or any other material evidence you considered and whether the monument was found or restored through acceptance of an obliterated evidence location.

I set an iron bar at this corner in February of 1980. Dick Berg used this as the corner in October of 1983. I found my old iron bar, removed it and replaced it with a brass capped Lunde marker. I also set a sign and post to the North and buried a liquor bottle, with an empty blank bullet, to the Southeast of the Lunde.

Describe or show any material discrepancy between the location of the restored corner and that of the corner previously restored or reestablished.

None known.

## WISCONSIN COORDINATE SYSTEM

North

East

Theta Angle

Horiz. Order

Vert. Order

## TYPE OF LANDMARK

Brass capped Lunde marker

## BEARINGS ARE REFERENCED TO

Assumed

