


21706100020

U. S. PUBLIC LAND SURVEY MONUMENT RECORD

SECTION 10 T 17 N, R 6 W, TOWN OF HAMILTON

LA CROSSE COUNTY

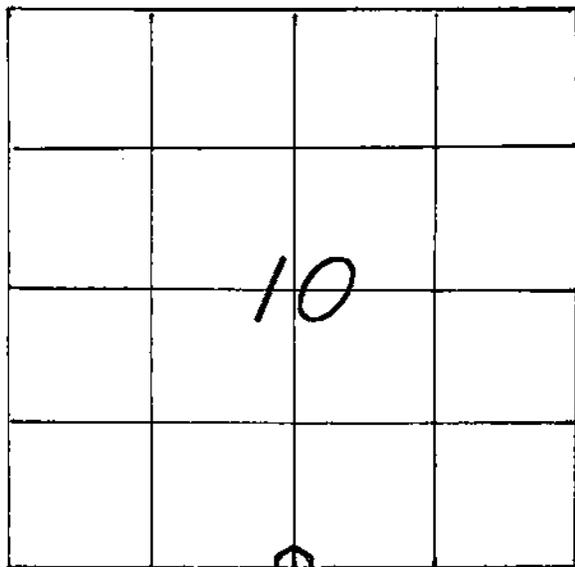

LOCATION OF LANDMARK

CREW: WILLIAM C. JUNG
 PETER F. FOLLANSBEE
 DATE: 11/05/1997

WISCONSIN COORDINATE SYSTEM

North

East

Theta Angle

Horiz. Order

Vert. Order

TYPE OF LANDMARK

3/4" x 30" ROUND IRON BAR w/BERNTSEN CAP.

BEARINGS ARE REFERENCED TO

Describe any record evidence, monument evidence, testimonial evidence or any other material evidence you considered and whether the monument was found or restored through acceptance of an obliterated evidence location.


Paul Fairchild set a spike at the corner. We both agreed that this location fit the section line very well. I accepted this location as the best available evidence of the original government corner position. I replaced Paul's spike with a capped iron bar. The bar is_{at} an old fence corner.

Describe or show any material discrepancy between the location of the restored corner and that of the corner previously restored or reestablished.

NONE KNOWN.

RECORD OF DURABLE WITNESS MONUMENTS
MAGNETIC

NO	DESCRIPTION	BEARING	DISTANCE
1	SET A NAIL IN N.W.-SIDE 18" OAK (SINGLE BLAZED)	S 25° W	28.18 FT.
2	SET A NAIL IN N.-SIDE DOUBLE W. OAK (DOUBLE BLAZED)	N 83° W	11.05 FT.
3	SET A NAIL IN S.E.-SIDE 23" OAK (SINGLE BLAZED)	N 60° E	24.37 FT.
4	SET A NAIL IN S.W.-SIDE 9" ELM (DOUBLE BLAZED)	S'EASTERLY ±	3.73 FT.

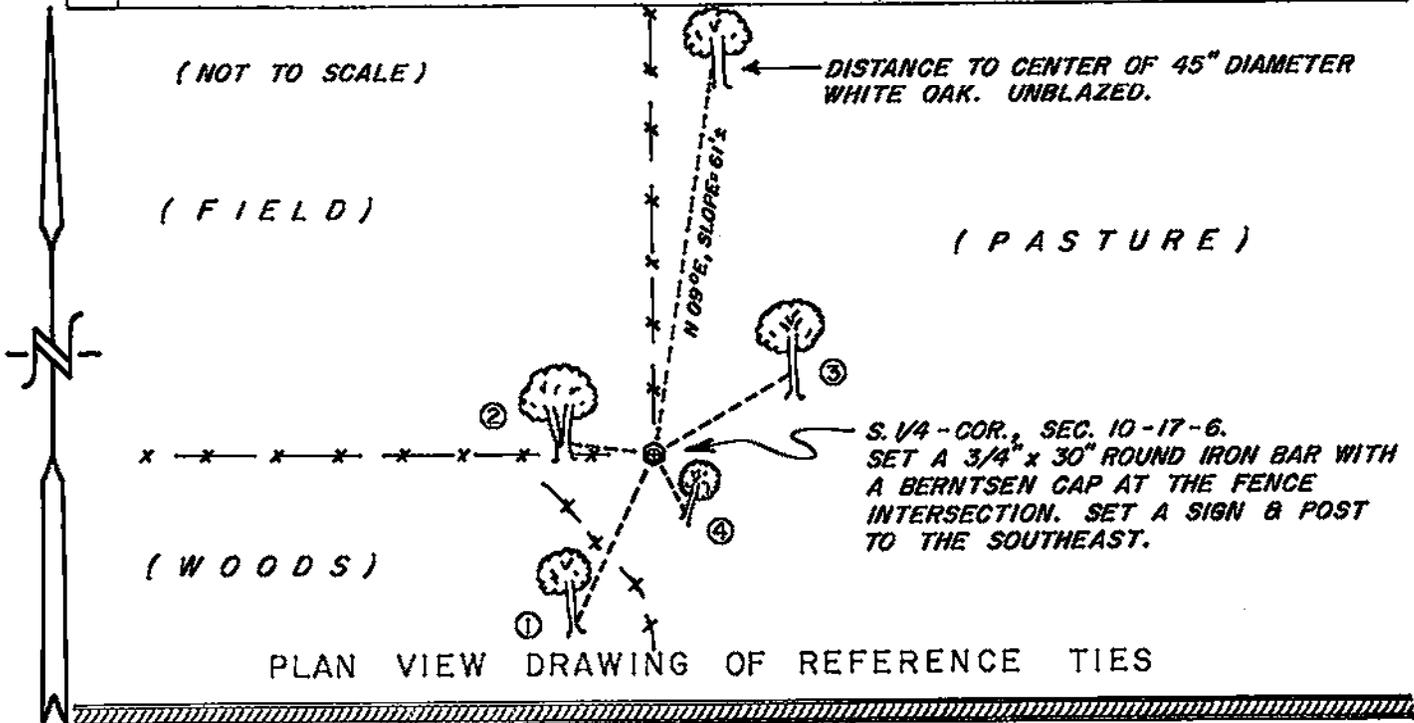


MAP SHOWING DISTANCE AND DIRECTION TO OTHER PUBLIC LAND SURVEY CORNERS USED FOR REESTABLISHING THE CORNER

No section measurements were made by me at this time. The section measurements were made by Fairchild.

I, WILLIAM C. JUNG, COUNTY SURVEYOR
HEREBY CERTIFY THAT THE CORNER LOCATION SHOWN ON THIS RECORD
WAS DETERMINED BY ME OR UNDER MY DIRECTION AND CONTROL AND
THAT THIS U. S. PUBLIC LAND SURVEY MONUMENT RECORD IS CORRECT
AND COMPLETE TO THE BEST OF MY KNOWLEDGE AND BELIEF.

William C. Jung 1/12/98
Signature Date

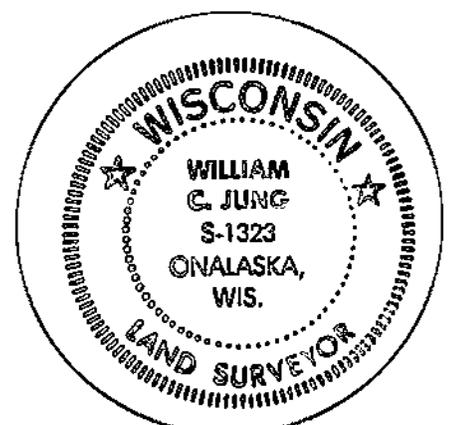

Seal