


U. S. PUBLIC LAND SURVEY MONUMENT RECORD

SECTION 10 T 17 N, R 6 W, TOWN OF HAMILTON  
 LA CROSSE COUNTY

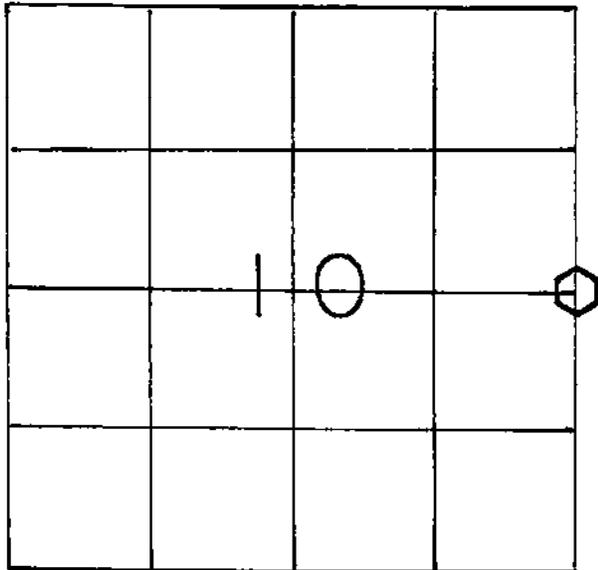

LOCATION OF LANDMARK

WISCONSIN COORDINATE SYSTEM
North
East
Theta Angle
Horiz. Order
Vert. Order
TYPE OF LANDMARK
Brass capped Lunde marker
BEARINGS ARE REFERENCED TO

Crew: William C. Jung  
 Peter F. Follansbee

Date: April 8, 1992

Describe any record evidence, monument evidence, testimonial evidence or any other material evidence you considered and whether the monument was found or restored through acceptance of an obliterated evidence location.

I found an iron pipe at the corner which had been used in previous survey work. I accepted the pipe as the best available evidence of the original government corner position and replaced it with a Lunde marker. A whiskey bottle with a shell casing was buried with the marker. A sign and post were set by the Lunde too. Also by the Lunde is a steel post.

Describe or show any material discrepancy between the location of the restored corner and that of the corner previously restored or reestablished.

None known.

