


21706110020

U. S. PUBLIC LAND SURVEY MONUMENT RECORD

SECTION 11 T 17 N, R 6 W, TOWN OF HAMILTON

LA CROSSE COUNTY

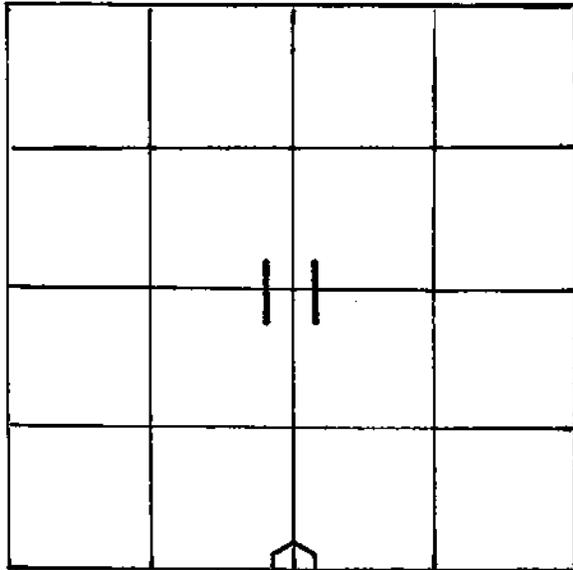

LOCATION OF LANDMARK

WISCONSIN COORDINATE SYSTEM

North

East

Theta Angle

Horiz. Order

Vert. Order

TYPE OF LANDMARK

Set brass cap Lunde marker.

BEARINGS ARE REFERENCED TO

True North.

Crew: WILLIAM C. JUNG
PETER F. FOLLANSBEE

Date: 12/06/1994

Describe any record evidence, monument evidence, testimonial evidence or any other material evidence you considered and whether the monument was found or restored through acceptance of an obliterated evidence location.


I set this corner in the old North-South fence and on line with the section corners and monumented it with a brass capped Lunde marker. I found wire tied off here (N-S) in three spots.

Describe or show any material discrepancy between the location of the restored corner and that of the corner previously restored or reestablished.

None Known.


RECORD OF DURABLE WITNESS MONUMENTS

NO	DESCRIPTION	BEARING	DISTANCE
1	Set P.K. Nail in SE-side 8½" White Oak	Southwesterly	22.79 Ft.
2	Set P.K. Nail in NW-side 10" Hickory	Southwesterly	31.89 Ft.
3	Set P.K. Nail in E.-side 8" White Oak	Southwesterly	24.92 Ft.
4	Previously set 1" Iron Pipe survey point	N0°03'32"W (true)	122.10 Ft.

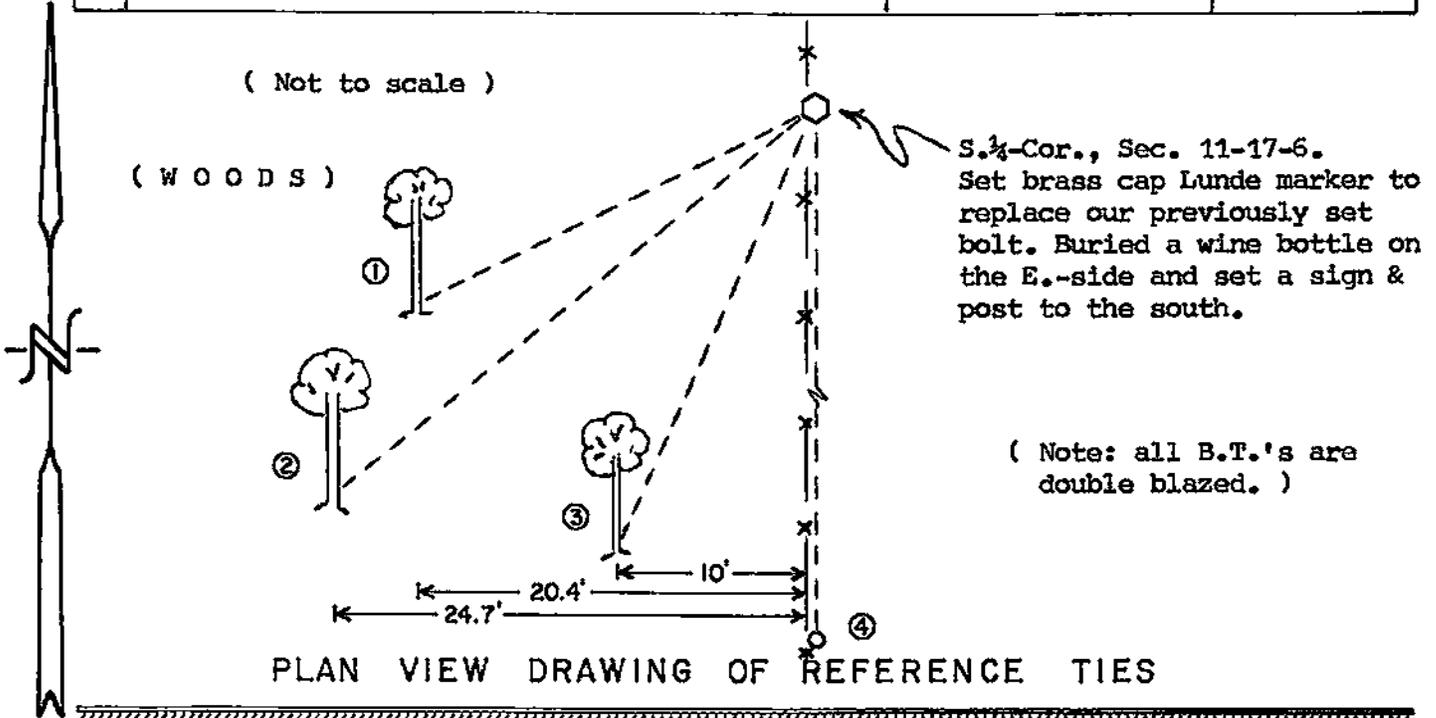

MAP SHOWING DISTANCE AND DIRECTION TO OTHER PUBLIC LAND SURVEY CORNERS USED FOR REESTABLISHING THE CORNER


(not to scale)

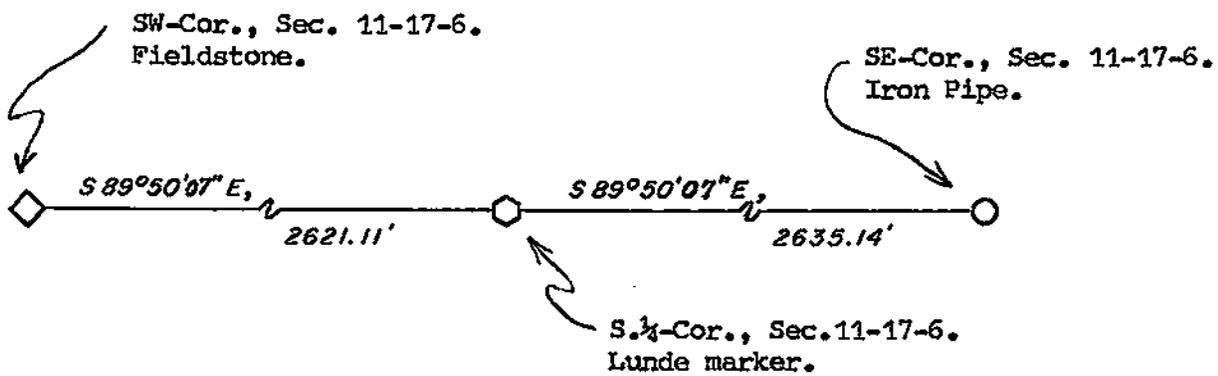

I, William C. Jung, County Surveyor
HEREBY CERTIFY THAT THE CORNER LOCATION SHOWN ON THIS RECORD
WAS DETERMINED BY ME OR UNDER MY DIRECTION AND CONTROL AND
THAT THIS U. S. PUBLIC LAND SURVEY MONUMENT RECORD IS CORRECT
AND COMPLETE TO THE BEST OF MY KNOWLEDGE AND BELIEF.

William C. Jung
Signature

2/7/95
Date

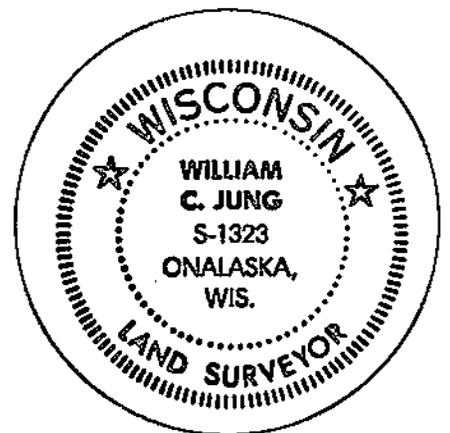

Seal