


21706120020

## U. S. PUBLIC LAND SURVEY MONUMENT RECORD

SECTION 12 T 17 N, R 6 W, TOWN OF Hamilton

LA CROSSE COUNTY

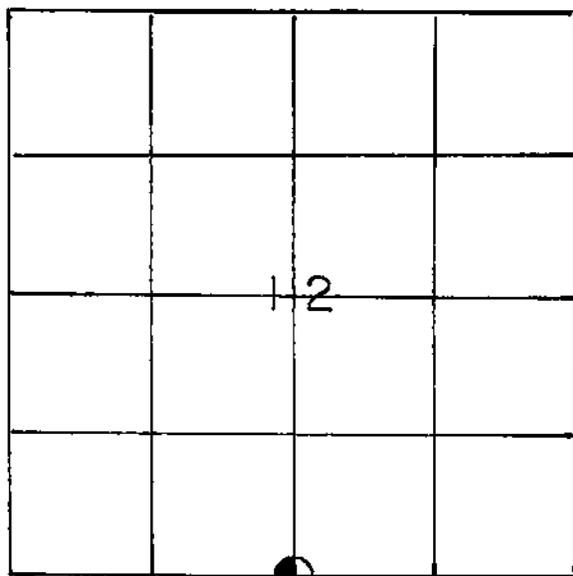

LOCATION OF LANDMARK

Crew: William C. Jung  
Perry L. Dahl

2-4-87

## WISCONSIN COORDINATE SYSTEM

North

East

Theta Angle

Horiz. Order

Vert. Order

## TYPE OF LANDMARK

1" iron pipe

## BEARINGS ARE REFERENCED TO

Bearings are referenced to True North as per Hofmeister's survey in 1983.

Describe any record evidence, monument evidence, testimonial evidence or any other material evidence you considered and whether the monument was found or restored through acceptance of an obliterated evidence location.


I set the corner on line with the old line fence to the East and equidistant between the section corners. The corner is almost on line with the section corners too. Also, this location is on line with the fence corner at the occupied Center 1/4 of Section 12 and the occupied fence corner 1/4 mile to the North of the S1/4.

Describe or show any material discrepancy between the location of the restored corner and that of the corner previously restored or reestablished.

None known.

RECORD OF DURABLE WITNESS MONUMENTS


NO	DESCRIPTION	BEARING	DISTANCE
1	Set a 1" iron pipe near the fence	North $\pm$	39.64'
2	P.K.nail in unblazed 16"cherry(sickly)	Magnetic=N78°E	25.50'
3	Set a 1" iron pipe in the fence	East $\pm$	54.87'
4			

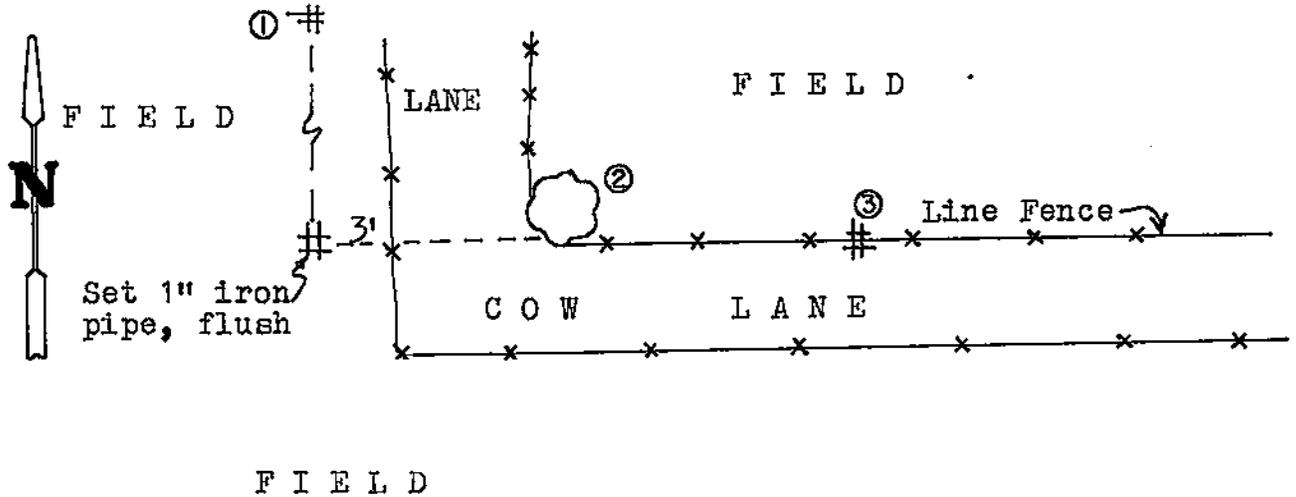

PLAN VIEW DRAWING OF REFERENCE TIES

MAP SHOWING DISTANCE AND DIRECTION TO OTHER PUBLIC LAND SURVEY CORNERS USED FOR REESTABLISHING THE CORNER

(not to scale)

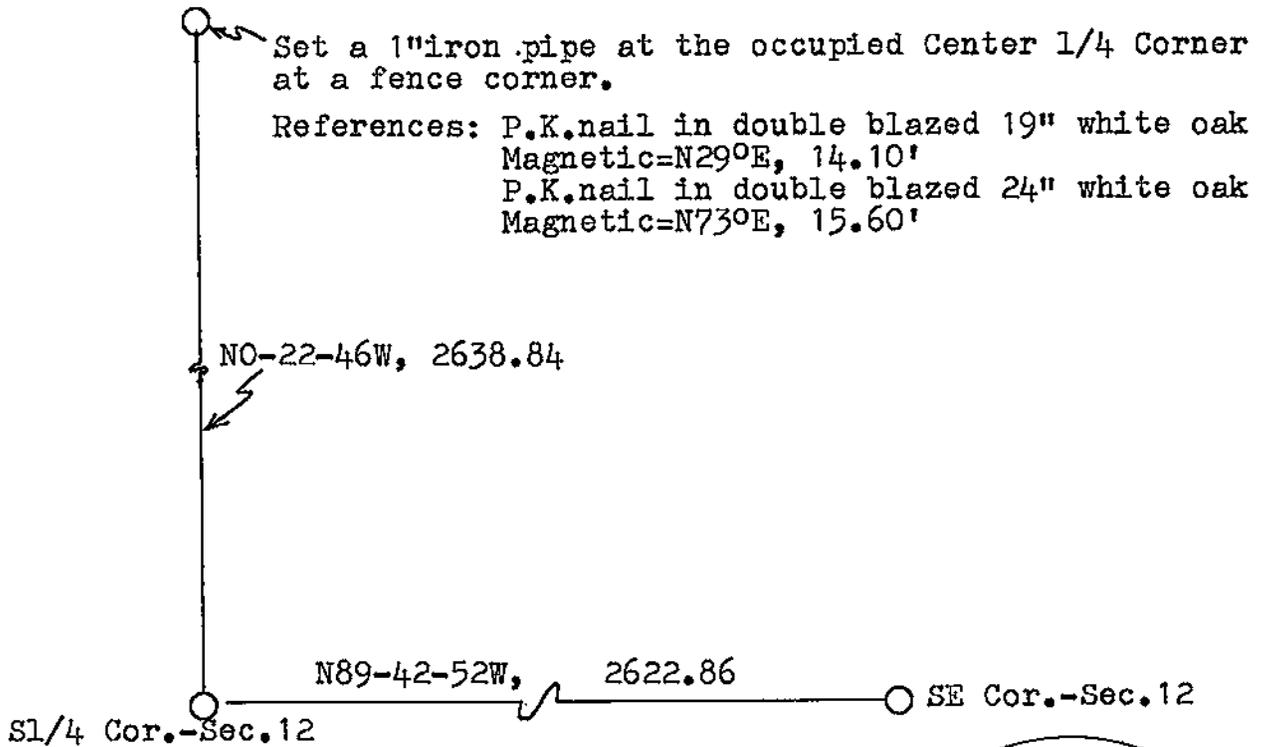

I, William C. Jung, Deputy County Surveyor,  
 HEREBY CERTIFY THAT THE CORNER LOCATION SHOWN ON THIS RECORD  
 WAS DETERMINED BY ME OR UNDER MY DIRECTION AND CONTROL AND  
 THAT THIS U. S. PUBLIC LAND SURVEY MONUMENT RECORD IS CORRECT  
 AND COMPLETE TO THE BEST OF MY KNOWLEDGE AND BELIEF.

William C. Jung  
 Signature

February 9, 1987  
 Date



Seal