


21706122020

U. S. PUBLIC LAND SURVEY MONUMENT RECORD

SECTION 12 T 17 N, R 6 W, TOWN OF HAMILTON

LA CROSSE COUNTY

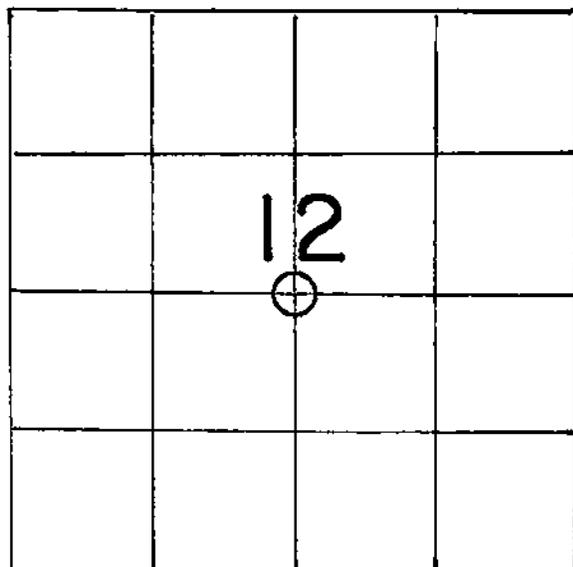

LOCATION OF LANDMARK

WISCONSIN COORDINATE SYSTEM

North

East

Theta Angle

Horiz. Order

Vert. Order

TYPE OF LANDMARK

Existing 1" Iron Pipe.

BEARINGS ARE REFERENCED TO

Crew: WILLIAM C. JUNG & PERRY DAHL.(2/04/1987)

PETER F. FOLLANSBEE

Date: 1/16/1995

Describe any record evidence, monument evidence, testimonial evidence or any other material evidence you considered and whether the monument was found or restored through acceptance of an obliterated evidence location.

The old fence corner falls about 9 feet North and 6 feet East of the true Center 1/4 corner. Based on the evidence that I found in Section 12, I feel that this corner was set years ago by a surveyor. The work may have been recorded but was lost when the old County Surveyor records disappeared. I accepted the fence corner as evidence of a corner set previously. It was probably intended to have been set at the intersection of the 1/4 lines. The amount that the corner is off ***

Describe or show any material discrepancy between the location of the restored corner and that of the corner previously restored or reestablished.

None Known.


*** is well within the error allowed by a surveyor, let's say, about a century ago.

RECORD OF DURABLE WITNESS MONUMENTS

MAGNETIC

NO	DESCRIPTION	BEARING	DISTANCE
1	Set P.K. Nail in S.-side 10" Maple(double blazed)	N 88° W	29.22 Ft.
2	Existing P.K. set in 1987 in NW-side 19" W. Oak	N 29° E	14.1 Ft.
3	Existing P.K. set in 1987 in SE-side 24" W. Oak	N 73° E	15.6 Ft.
4	Set P.K. Nail in E.-side 9" Oak(double blazed)	S 23° W	Sl.= 79.43'

(Scale: 1" = 30')

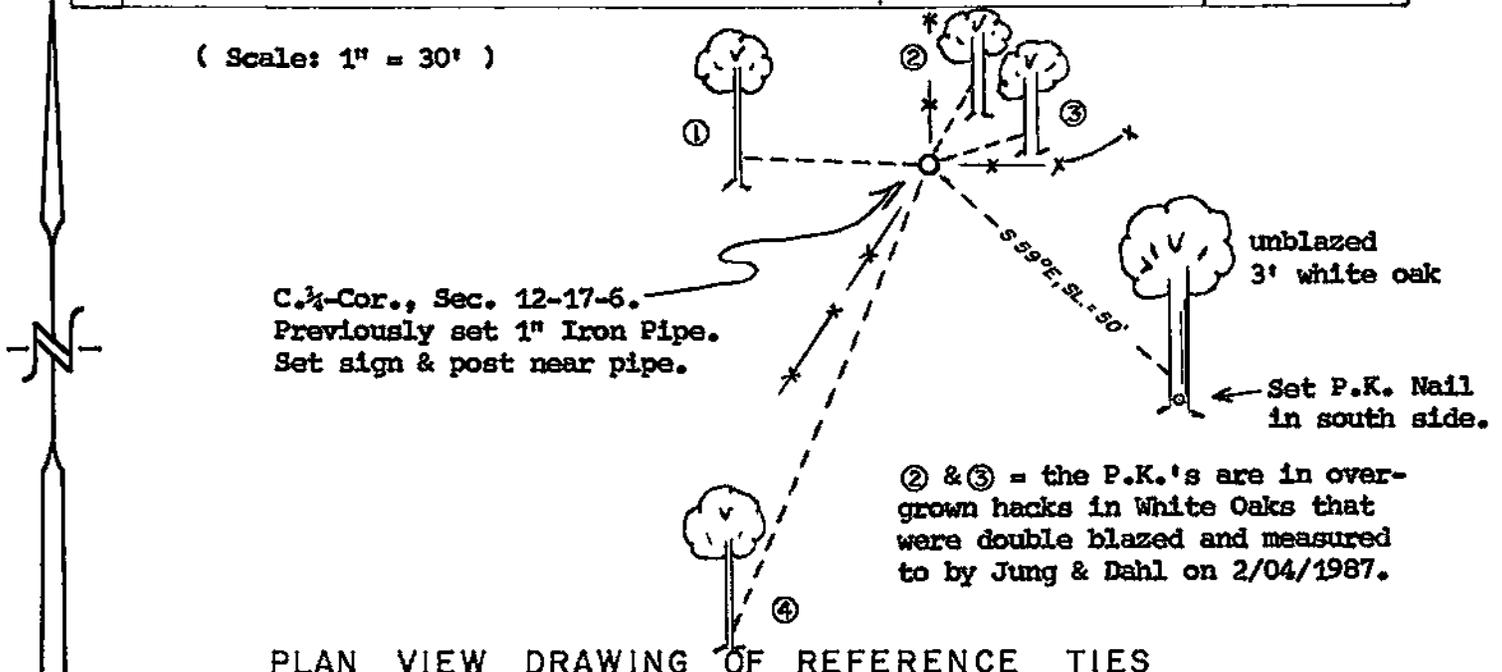

PLAN VIEW DRAWING OF REFERENCE TIES

MAP SHOWING DISTANCE AND DIRECTION TO OTHER PUBLIC LAND SURVEY CORNERS USED FOR REESTABLISHING THE CORNER

Note: Check County Surveyor work file #39 for this data.

I, William C. Jung, County Surveyor
HEREBY CERTIFY THAT THE CORNER LOCATION SHOWN ON THIS RECORD WAS DETERMINED BY ME OR UNDER MY DIRECTION AND CONTROL AND THAT THIS U. S. PUBLIC LAND SURVEY MONUMENT RECORD IS CORRECT AND COMPLETE TO THE BEST OF MY KNOWLEDGE AND BELIEF.

William C. Jung 2/10/95
Signature Date



Seal