


U. S. PUBLIC LAND SURVEY MONUMENT RECORD

SECTION 24 T 17 N, R 6 W, TOWN OF HAMILTON

LA CROSSE COUNTY

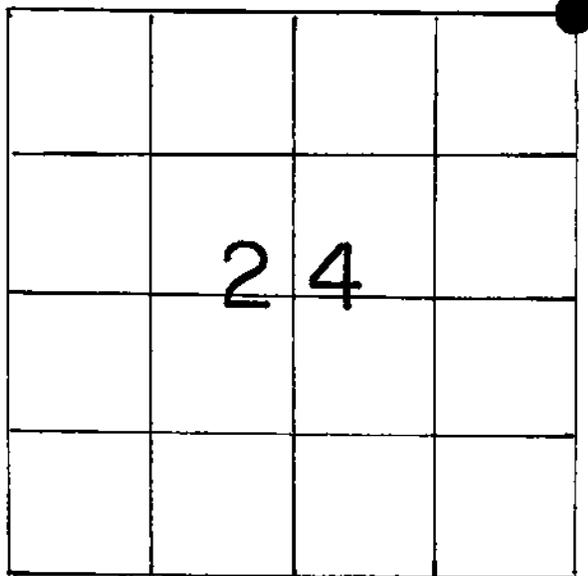

LOCATION OF LANDMARK

WISCONSIN COORDINATE SYSTEM

North

East

Theta Angle

Horiz. Order

Vert. Order

TYPE OF LANDMARK

Brass capped Lunde marker

BEARINGS ARE REFERENCED TO

True

Crew: William C. Jung
Peter F. Follansbee

Date: December 17, 1992

Describe any record evidence, monument evidence, testimonial evidence or any other material evidence you considered and whether the monument was found or restored through acceptance of an obliterated evidence location.

The original notes call for this corner to be 4 links North and 3 chains West of the cliff. I set the corner using the topographic tie and found that it falls almost on line with NW and N1/4 corners. The fence going to the South at the N1/16NE corner splits my final 1/2 mile. I did not think it appropriate to set the corner by single proportionate measurement. A brass capped Lunde was set with a whiskey bottle with shell casing buried on the South side of the Lunde.

Describe or show any material discrepancy between the location of the restored corner and that of the corner previously restored or reestablished.

None known.

