


21706140000

U. S. PUBLIC LAND SURVEY MONUMENT RECORD

SECTION 23 T 17 N, R 6 W, TOWN OF Hamilton

LA CROSSE COUNTY

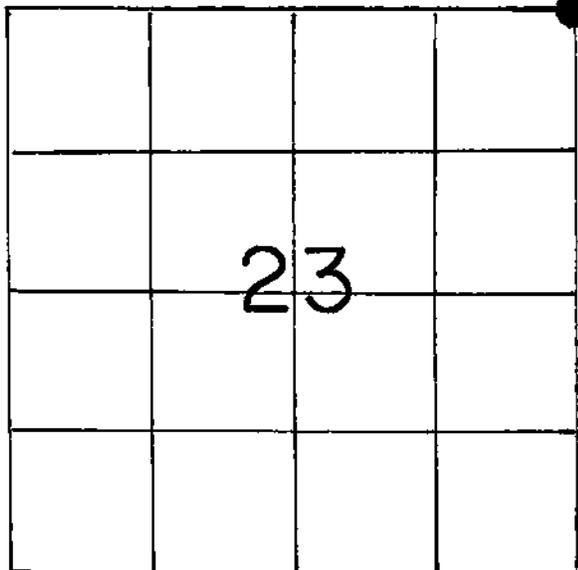

LOCATION OF LANDMARK

Crew: William C. Jung
Peter F. Follansbee

Date: November 5, 1990

Describe any record evidence, monument evidence, testimonial evidence or any other material evidence you considered and whether the monument was found or restored through acceptance of an obliterated evidence location.

The old occupied fence corner was accepted as the best available evidence of the original government corner position and was monumented with a Lunde marker. It was used as the corner in four surveys in the four surrounding sections including surveys by Hurlburt, Solberg, and Berg.

Describe or show any material discrepancy between the location of the restored corner and that of the corner previously restored or reestablished.

None known.

WISCONSIN COORDINATE SYSTEM

North

East

Theta Angle

Horiz. Order

Vert. Order

TYPE OF LANDMARK


Brass capped Lunde marker

BEARINGS ARE REFERENCED TO

RECORD OF DURABLE WITNESS MONUMENTS

NO	DESCRIPTION	BEARING	DISTANCE
1	Set 1 1/4" iron pipe in the fence	West ±	19.59
2	"	East ±	32.70
3	"	South ±	32.78
4			

Removed Hurlburt's nail and replaced it with a Lunde marker. Found the remnants of a wood post while digging. Buried a whiskey bottle with an empty shell casing in it on the North side of the Lunde.

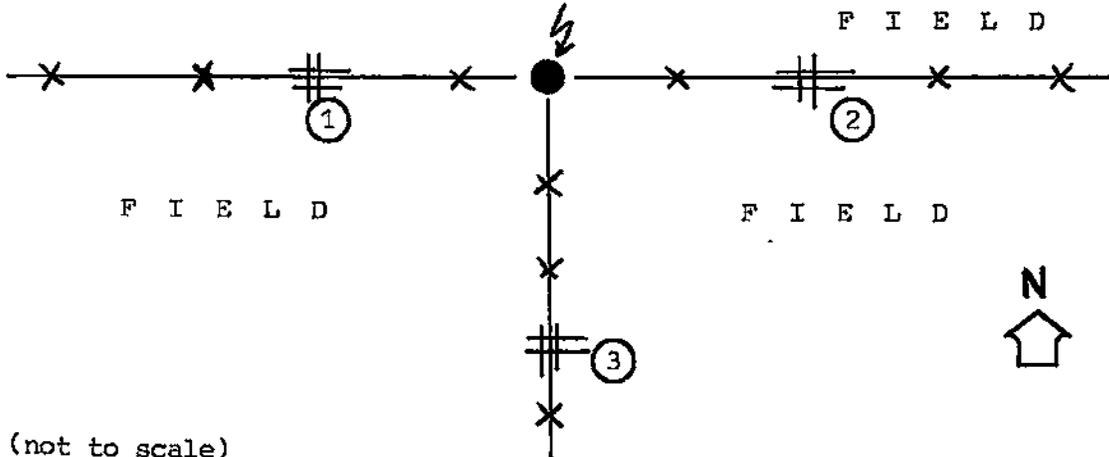

(not to scale)

PLAN VIEW DRAWING OF REFERENCE TIES


MAP SHOWING DISTANCE AND DIRECTION TO OTHER PUBLIC LAND SURVEY CORNERS USED FOR REESTABLISHING THE CORNER

Note: No section measurements made by me at this time.

I, William C. Jung, Deputy County Surveyor,
 HEREBY CERTIFY THAT THE CORNER LOCATION SHOWN ON THIS RECORD
 WAS DETERMINED BY ME OR UNDER MY DIRECTION AND CONTROL AND
 THAT THIS U. S. PUBLIC LAND SURVEY MONUMENT RECORD IS CORRECT
 AND COMPLETE TO THE BEST OF MY KNOWLEDGE AND BELIEF.

William C. Jung
 Signature

January 11, 1991
 Date

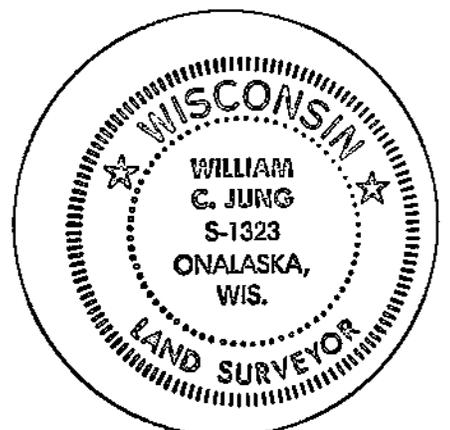

Seal