


21706140020

U. S. PUBLIC LAND SURVEY MONUMENT RECORD

SECTION 23 T 17 N, R 6 W, TOWN OF HAMILTON

LA CROSSE COUNTY

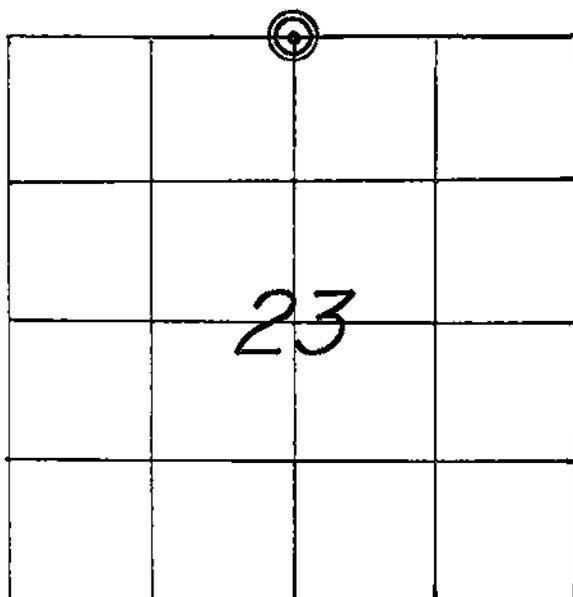

WISCONSIN COORDINATE SYSTEM	
North	709,757.664
East	1,688,843.149
Theta Angle	
Horiz. Order	
Vert. Order	
DATUM:	1983('91)
TYPE OF LANDMARK	
P.K. NAIL WITH CAP.	
BEARINGS ARE REFERENCED TO	
GRID NORTH AS PER SECTION DATA.	

LOCATION OF LANDMARK

CREW: WILLIAM C. JUNG
 PETER F. FOLLANSBEE
 DATE: 9/05/2002

Describe any record evidence, monument evidence, testimonial evidence or any other material evidence you considered and whether the monument was found or restored through acceptance of an obliterated evidence location.


In March of 1981 Clayton Solberg set a P.K. nail in the centerline of "C" and on line with a line fence to the East. This P.K. nail was knocked out during repaving sometime after 1990. In May of 1940 the old school site was resurveyed, probably by a WPA or CCC survey crew. I set a P.K. nail and cap at Solberg's old survey point location. After measuring West and South to the existing school fences, it appears that this location fits the 1940 1/4 corner location.

Describe or show any material discrepancy between the location of the restored corner and that of the corner previously restored or reestablished.


The description in Volume 401 Records, Page 586, would indicate that the school site was also surveyed in 1965. If so, the survey is unrecorded. The 1/4 corner called for in this document probably does not match my corner location.

RECORD OF DURABLE WITNESS MONUMENTS

NO	DESCRIPTION	BEARING	DISTANCE
1	EXISTING HEADLESS P.K. AT CENTERLINE INTERSECTION	NORTH ±	8.10 FT.
2	SET A 3/4" x 30" IRON BAR 4' EAST OF PAVEMENT	EAST ±	16.44 FT.
3	SET A 3/4" x 30" IRON BAR 6' WEST OF PAVEMENT	S.'WESTERLY ±	42.08 FT.
4	SET A 3/4" x 30" IRON BAR 6' SOUTH OF PAVEMENT	S.'WESTERLY ±	49.58 FT.

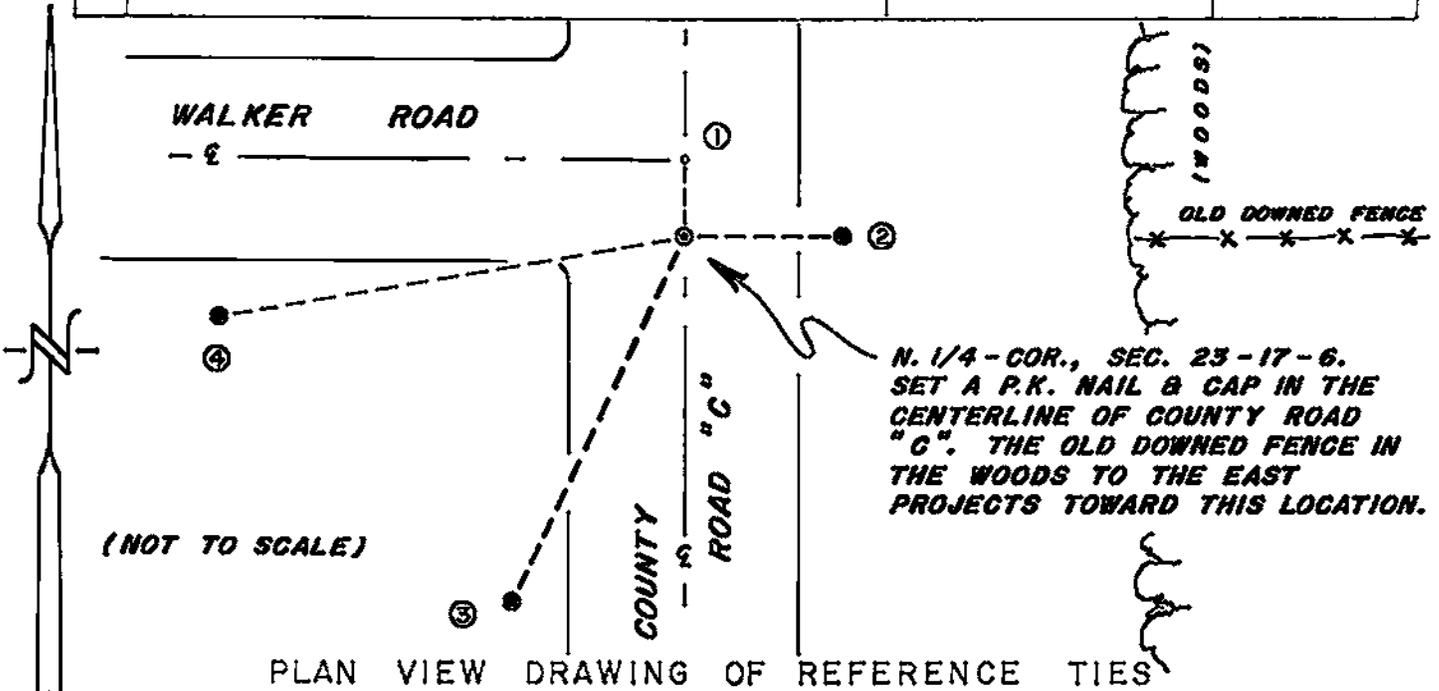

MAP SHOWING DISTANCE AND DIRECTION TO OTHER PUBLIC LAND SURVEY CORNERS USED FOR REESTABLISHING THE CORNER

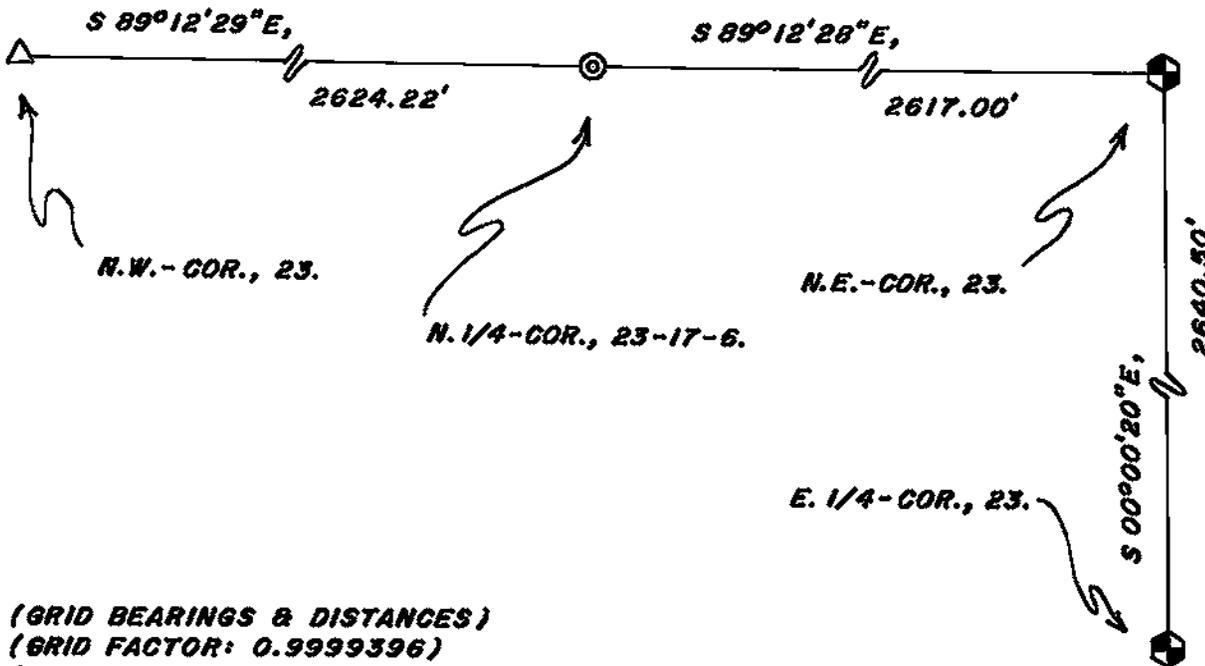

I, WILLIAM C. JUNG, COUNTY SURVEYOR
HEREBY CERTIFY THAT THE CORNER LOCATION SHOWN ON THIS RECORD WAS DETERMINED BY ME OR UNDER MY DIRECTION AND CONTROL AND THAT THIS U. S. PUBLIC LAND SURVEY MONUMENT RECORD IS CORRECT AND COMPLETE TO THE BEST OF MY KNOWLEDGE AND BELIEF.

William C. Jung
Signature

12/26/02
Date



Seal