


21706142000

U. S. PUBLIC LAND SURVEY MONUMENT RECORD

SECTION 14 T 17 N, R 6 W, TOWN OF HAMILTON

LA CROSSE COUNTY

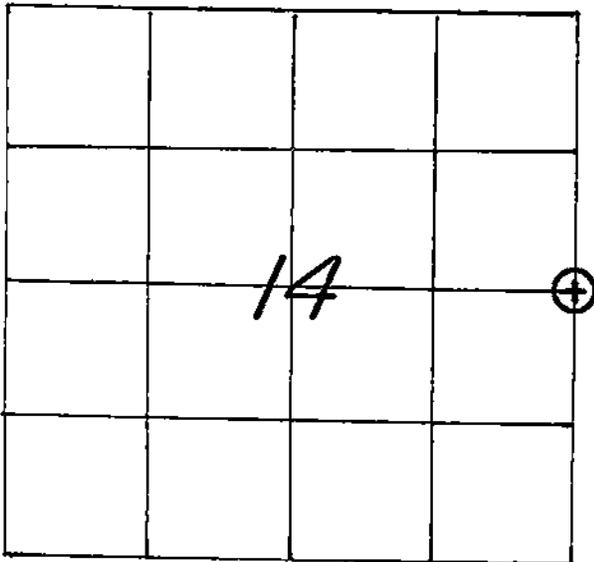

WISCONSIN COORDINATE SYSTEM

North

East

Theta Angle

Horiz. Order

Vert. Order

TYPE OF LANDMARK

3/4" x 30" IRON BAR WITH AN ALUMINUM CAP.

BEARINGS ARE REFERENCED TO

LOCATION OF LANDMARK

CREW: WILLIAM C. JUNG
 PETER F. FOLLANSBEE
 DATE: 7/30/2004

Describe any record evidence, monument evidence, testimonial evidence or any other material evidence you considered and whether the monument was found or restored through acceptance of an obliterated evidence location.

I found what I believe is the original bearing tree stump in the Southwest quadrant. It is rotted and has a diameter of about 2.5 feet. Using the original calls from this stump, I set an iron bar and cap at this corner with a sign and post nearby. The bar is about 2.5 feet West of the center of a railroad tie post at the ^{fence} corner. Mr. Lueck, the neighbor to the East, said that the North-South fence was rebuilt in the last 12 or 13 years, although it was obvious that there had been another North-South fence here


Describe or show any material discrepancy between the location of the restored ^{in the past.} corner and that of the corner previously restored or reestablished.

On his map of survey, dated December 13, 1990, Norm Hurlburt shows an unmarked 1/4 corner at this point. Dick Berg found a nail at what appears to be Hurlburt's point. I replaced the nail with an iron bar with a Berntsen cap, about S82°E, 7.88 feet from my final corner. I do not agree with Hurlburt's corner. This discrepancy should not affect the lot corners of the certified survey maps of record in Section 13 and 14.

RECORD OF DURABLE WITNESS MONUMENTS

MAGNETIC

NO	DESCRIPTION	BEARING	DISTANCE
1	SET A NAIL IN N.-SIDE OF A 25 1/2" WHITE OAK	N 74° W	32.13 FT.
2	SET A NAIL IN N.-SIDE OF A 15 1/2" WHITE OAK	N 86° W	43.32 FT.
3	SET A NAIL IN S.E.-SIDE OF A 19" WHITE OAK	S 40° W	50.73 FT.
4	SET A NAIL IN S.E.-SIDE OF AN 18" CHERRY	S 07° W	49.50 FT.

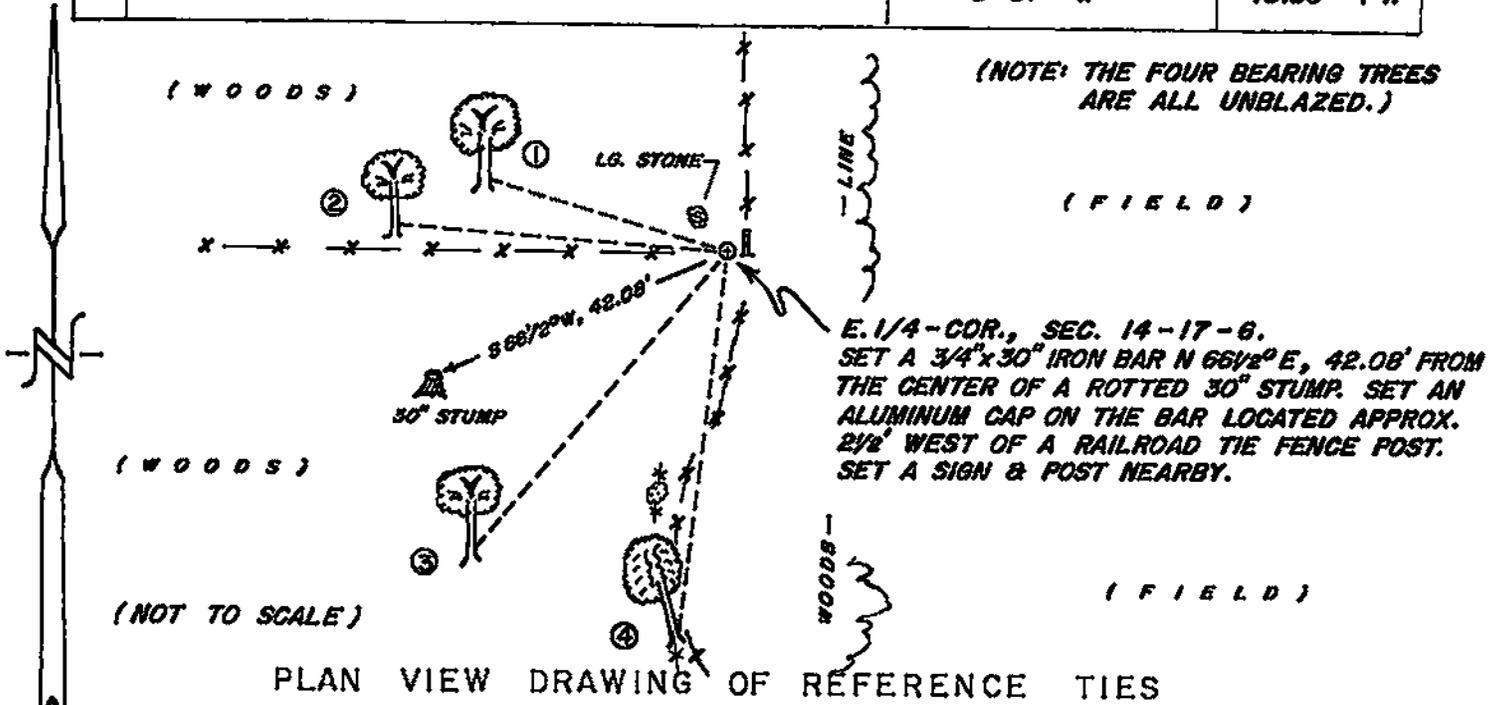


MAP SHOWING DISTANCE AND DIRECTION TO OTHER PUBLIC LAND SURVEY CORNERS USED FOR REESTABLISHING THE CORNER

I did not make any section measurements at this time. Section data of record confirmed the location of this corner.

I, WILLIAM C. JUNG, COUNTY SURVEYOR
 HEREBY CERTIFY THAT THE CORNER LOCATION SHOWN ON THIS RECORD WAS DETERMINED BY ME OR UNDER MY DIRECTION AND CONTROL AND THAT THIS U. S. PUBLIC LAND SURVEY MONUMENT RECORD IS CORRECT AND COMPLETE TO THE BEST OF MY KNOWLEDGE AND BELIEF.

William C. Jung 11/1/04
 Signature Date

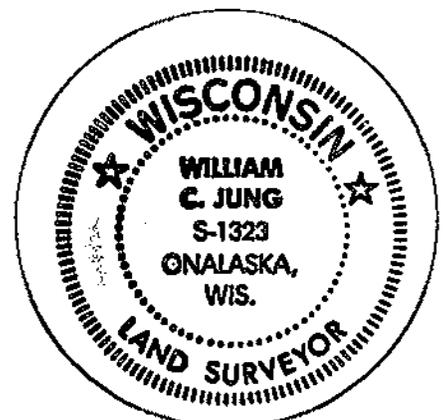

Seal