


21706150000

## U. S. PUBLIC LAND SURVEY MONUMENT RECORD

SECTION 14 T 17 N, R 6 W, TOWN OF HAMILTON

LA CROSSE COUNTY

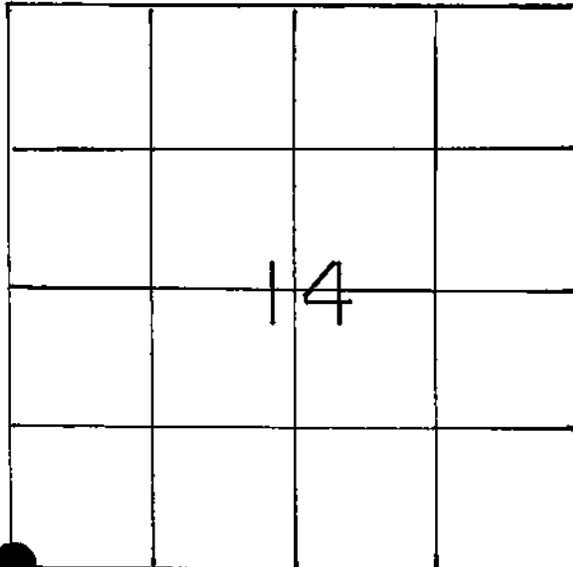

LOCATION OF LANDMARK

Crew: William Jung

8/28/84

## WISCONSIN COORDINATE SYSTEM

North 709,793.935

East 1,686,219.180

Theta Angle

Horiz. Order

Vert. Order

DATUM: 1983 ('91)

## TYPE OF LANDMARK

BERNTSEN (w/RRS Over It)

BEARINGS ARE REFERENCED TO

7/9/87 Jung &amp; Mickschl

The road had been repaved and the Berntsen was buried. I set a railroad spike over the top of it.

Describe any record evidence, monument evidence, testimonial evidence or any other material evidence you considered and whether the monument was found or restored through acceptance of an obliterated evidence location.


I set an 11/16"x24" iron bar at this corner in November of 1979. This was used as the corner for the highway plan for the bridge to the East. Connell used the bar as the corner in June of 1980; Clayton Solberg did in March of 1981; and Berg did in June of 1984. I accepted this position in 1979 as the best available evidence of the original government corner. I removed my old iron bar (now bent) and replaced it with a Berntsen marker.

Describe or show any material discrepancy between the location of the restored corner and that of the corner previously restored or reestablished.

None known.

RECORD OF DURABLE WITNESS MONUMENTS

NO	DESCRIPTION	BEARING	DISTANCE
1	SET 1" IRON PIPE	—————	40.33'
2	SET 1 3/8" IRON PIPE	SOUTH ±	24.65'
3	SET 1 1/4" IRON PIPE	—————	29.86'
4	SET 1 3/8" IRON PIPE	NORTH ±	24.85'

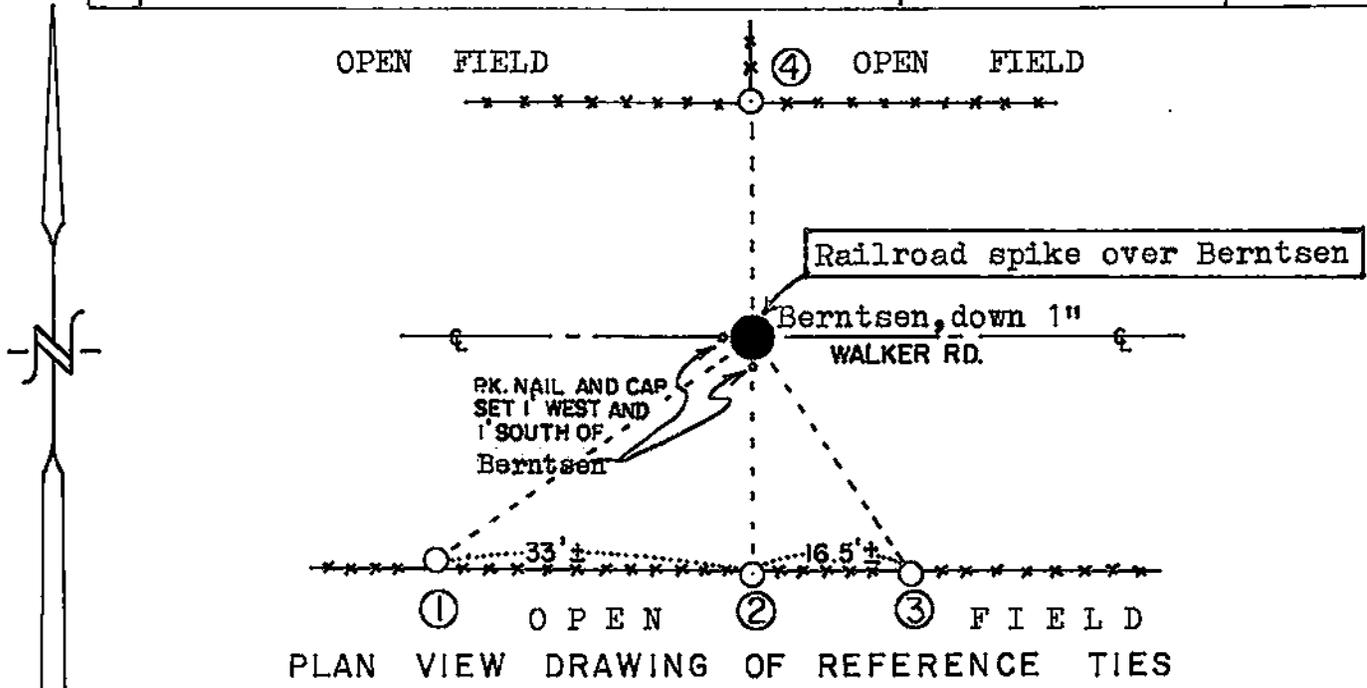

MAP SHOWING DISTANCE AND DIRECTION TO OTHER PUBLIC LAND SURVEY CORNERS USED FOR REESTABLISHING THE CORNER

See maps of record.

I, William C. Jung, Deputy County Surveyor,  
 HEREBY CERTIFY THAT THE CORNER LOCATION SHOWN ON THIS RECORD  
 WAS DETERMINED BY ME OR UNDER MY DIRECTION AND CONTROL AND  
 THAT THIS U. S. PUBLIC LAND SURVEY MONUMENT RECORD IS CORRECT  
 AND COMPLETE TO THE BEST OF MY KNOWLEDGE AND BELIEF.

William C. Jung  
 Signature

2/10/86  
 Date

Revised: 12/18/87

" 11/19/01 *adef*



Seal