


21706150020

## U. S. PUBLIC LAND SURVEY MONUMENT RECORD

SECTION 15 T 17 N, R 6 W, TOWN OF HAMILTON

LA CROSSE COUNTY

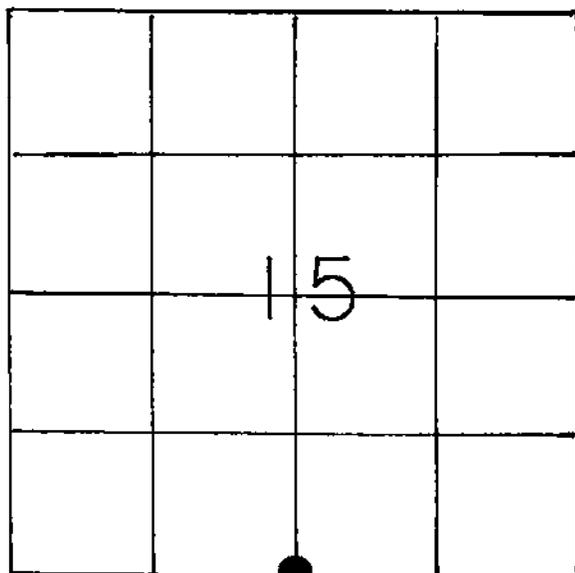

LOCATION OF LANDMARK

Crew: William C. Jung  
Peter F. Follansbee

Date: April 7, 1992

Describe any record evidence, monument evidence, testimonial evidence or any other material evidence you considered and whether the monument was found or restored through acceptance of an obliterated evidence location.

Berg set a spike at the occupied fence corner in 1984. I accepted this location as the best available evidence of the original government corner position. The spike was replaced with a Lunde marker. I talked to the surrounding three farmers and they all agreed that this location was the corner as far as they knew. The Lunde is South of the fence post with a sign and post North of it. A wine bottle with a shell casing in it is buried South of the Lunde.

Describe or show any material discrepancy between the location of the restored corner and that of the corner previously restored or reestablished.

None known.

## WISCONSIN COORDINATE SYSTEM

North

East

Theta Angle

Horiz. Order

Vert. Order


## TYPE OF LANDMARK

Brass capped Lunde marker

BEARINGS ARE REFERENCED TO

RECORD OF DURABLE WITNESS MONUMENTS

NO	DESCRIPTION	BEARING	DISTANCE
1	Set 1" iron pipe	-----	29.64
2	P.K. nail in an unblazed 26" oak. There appears to be a scar on it. Is it an unrecorded B.T.?	-----	slope=44.30
3	P.K. nail in unblazed 6" tree (species?)	Magnetic = N35°E	" =29.22
4	P.K. nail in unblazed 27" burr oak	-----	" =14.46

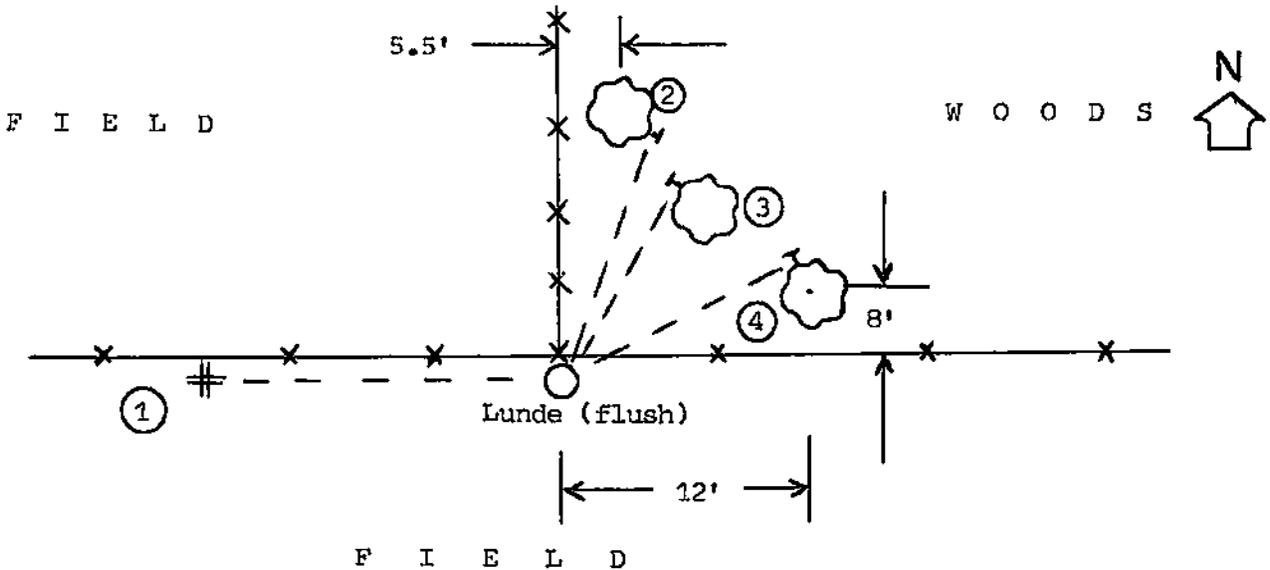

(not to scale)

PLAN VIEW DRAWING OF REFERENCE TIES

MAP SHOWING DISTANCE AND DIRECTION TO OTHER PUBLIC LAND SURVEY CORNERS USED FOR REESTABLISHING THE CORNER

No section measurements made by me at this time. Position confirmed by previous survey work.

I, William C. Jung, Deputy County Surveyor,  
 HEREBY CERTIFY THAT THE CORNER LOCATION SHOWN ON THIS RECORD  
 WAS DETERMINED BY ME OR UNDER MY DIRECTION AND CONTROL AND  
 THAT THIS U. S. PUBLIC LAND SURVEY MONUMENT RECORD IS CORRECT  
 AND COMPLETE TO THE BEST OF MY KNOWLEDGE AND BELIEF.

William C. Jung  
 Signature

June 4, 1992  
 Date



Seal