

 U. S. PUBLIC LAND SURVEY MONUMENT RECORD

SECTION 14 T 17 N, R 6 W, TOWN OF HAMILTON

LACROSSE COUNTY

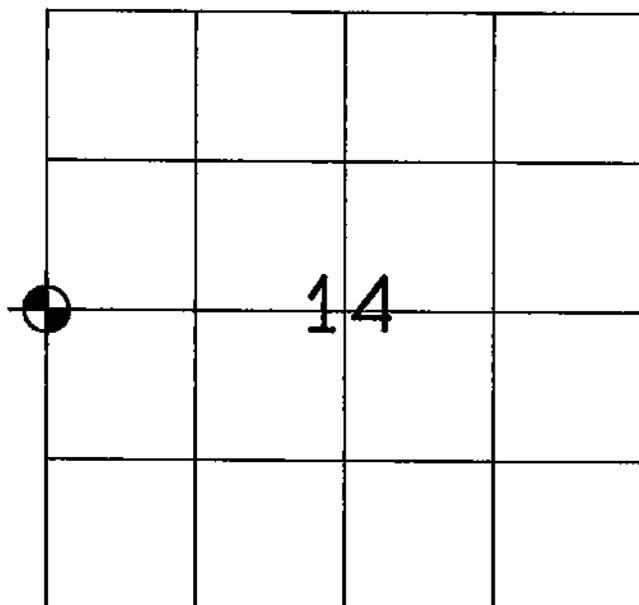

LOCATION OF LANDMARK

WISCONSIN COORDINATE SYSTEM
NORTH
EAST
THETA ANGLE
HORIZ. ORDER
VERT. ORDER
TYPE OF LANDMARK SET 1.315" OD X 24" I.P.
BEARINGS ARE REFERENCED TO ASSUMED

CREW: RICHARD A. BERG
DUSTIN B. BERG

DATE: 6/21/2004

Describe any record evidence, monument evidence, testimonial evidence or any other material evidence you considered and whether the monument was found or restored through acceptance of an obliterated evidence location.


A search of the area revealed no occupation or other physical evidence at or near the corner location. We set a 1.315" od x 24" iron pipe midway and on-line between the northwest section corner and the southwest section corner.

Describe or show any material discrepancy between the location of the restored corner and that of the corner previously restored or reestablished.

None Known.

RECORD OF DURABLE WITNESS MONUMENTS


NO	DESCRIPTION	MAGNETIC BEARING	DISTANCE
1	SET P.K. NAIL IN NE-SIDE 9" ELM	N35 °W	16.98'
2	SET P.K. NAIL IN NW-SIDE 6" ELM	N69 °E	8.94'
3	SET P.K. NAIL IN SW-SIDE 8" ELM	S39 °E	15.35'
4	10" SPIKE IN GROUND	S90 °W	51.87'

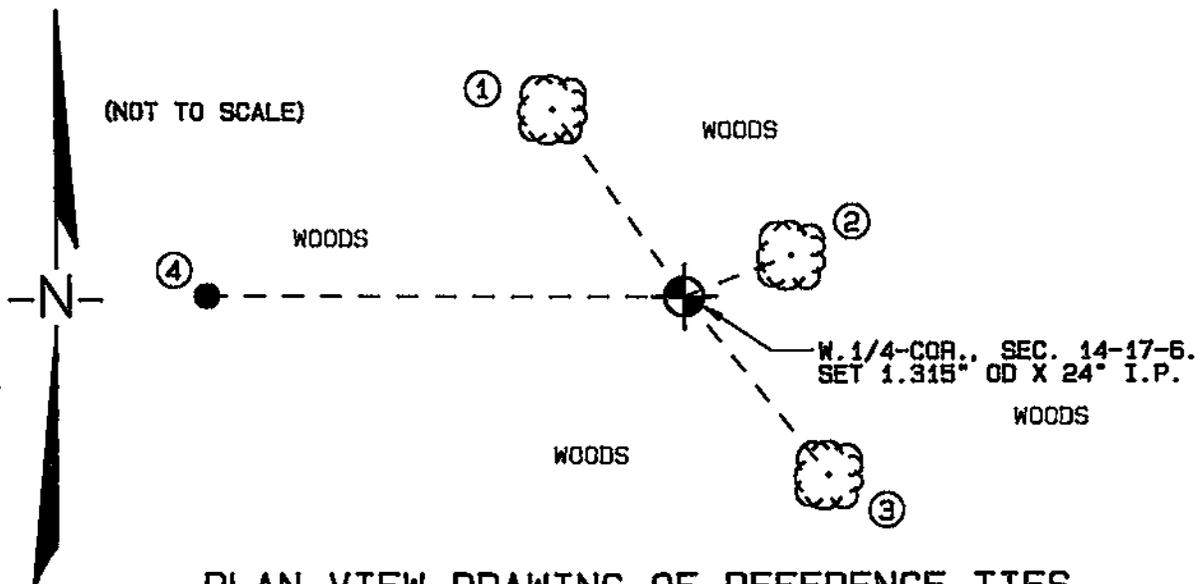

PLAN VIEW DRAWING OF REFERENCE TIES

MAP SHOWING DISTANCE AND DIRECTION TO OTHER PUBLIC LAND SURVEY CORNERS USED FOR REESTABLISHING THE CORNER

(NOT TO SCALE)

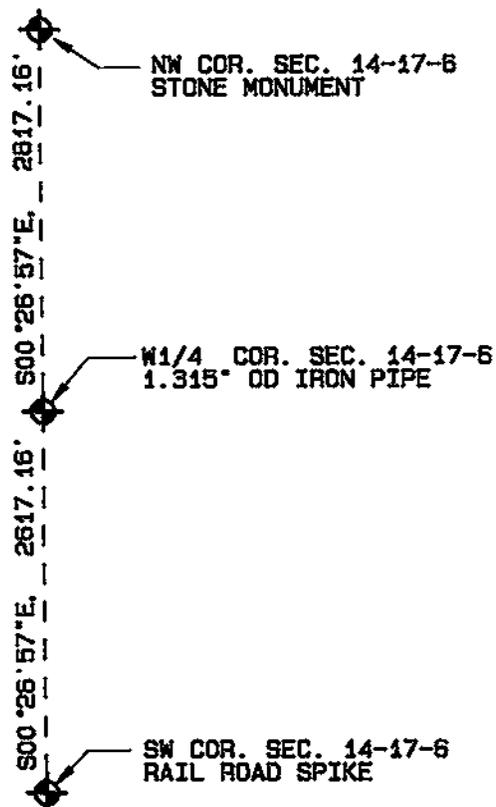

I, RICHARD A. BERG, REGISTERED LAND SURVEYOR

HEREBY CERTIFY THAT THE CORNER LOCATION SHOWN ON THIS RECORD WAS DETERMINED BY ME OR UNDER MY DIRECTION AND CONTROL AND THAT THIS U. S. PUBLIC LAND SURVEY MONUMENT RECORD IS CORRECT AND COMPLETE TO THE BEST OF MY KNOWLEDGE AND BELIEF.

Richard A Berg
SIGNATURE

6-23-04
DATE

