


U. S. PUBLIC LAND SURVEY MONUMENT RECORD

SECTION 16 T 17 N, R 6 W, TOWN OF HAMILTON

LA CROSSE COUNTY

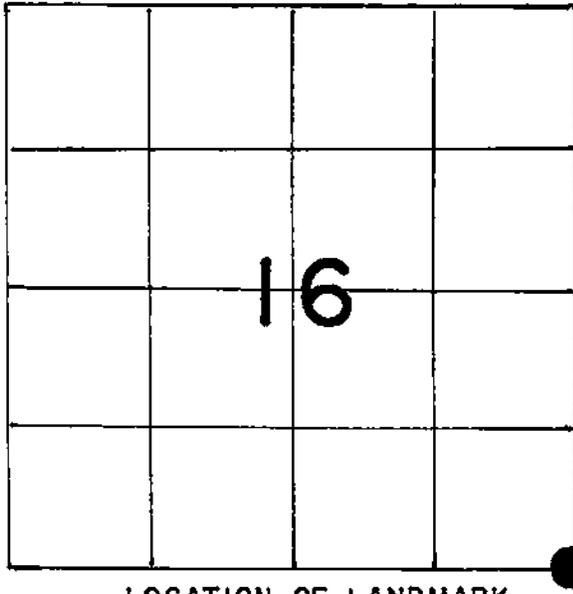

LOCATION OF LANDMARK

Crew: William Jung
 Perry Dahl
 5/7/85

WISCONSIN COORDINATE SYSTEM

North

East

Theta Angle

Horiz. Order

Vert. Order

TYPE OF LANDMARK

BERNTSEN

BEARINGS ARE REFERENCED TO

Assumed

Describe any record evidence, monument evidence, testimonial evidence or any other material evidence you considered and whether the monument was found or restored through acceptance of an obliterated evidence location.

Dick Berg set a spike at this corner in June of 1984. I did not find Berg's spike, so I set a Berntsen monument on the West side of the fence corner post. 40 feet South of the corner is a tie post. At a dist. & bearing of $S8^{\circ}W$, 75' from the corner is the center of a large white oak with a possible blaze on the NE side. I accepted the occupied fence corner as the best possible evidence of the original government corner.


Describe or show any material discrepancy between the location of the restored corner and that of the corner previously restored or reestablished.

None known.

RECORD OF DURABLE WITNESS MONUMENTS


NO	DESCRIPTION	BEARING	DISTANCE
1	DOUBLE-BLAZED 11" OAK TREE WITH P.K. NAIL	N26°W	25.37'
2	DOUBLE-BLAZED 12" OAK TREE WITH P.K. NAIL	S12°W	28.11'
3	DOUBLE-BLAZED 13" WHITE OAK WITH P.K.	N35°E	57.21'
4	SINGLE-BLAZED 20" WHITE OAK WITH P.K.	N4°E	39.54'

(Each distance is to a P.K. nail in a hack on the side of the tree. All bearings are magnetic using a hand compass.)

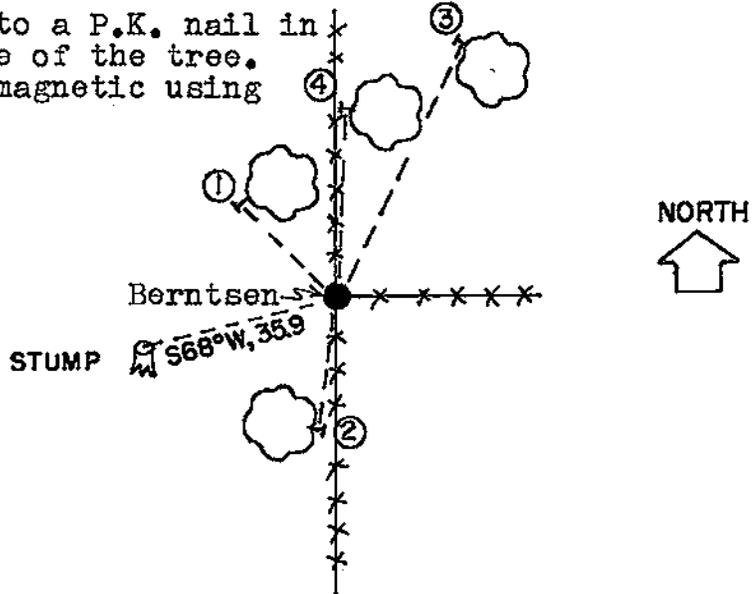

PLAN VIEW DRAWING OF REFERENCE TIES

MAP SHOWING DISTANCE AND DIRECTION TO OTHER PUBLIC LAND SURVEY CORNERS USED FOR REESTABLISHING THE CORNER (not to scale)

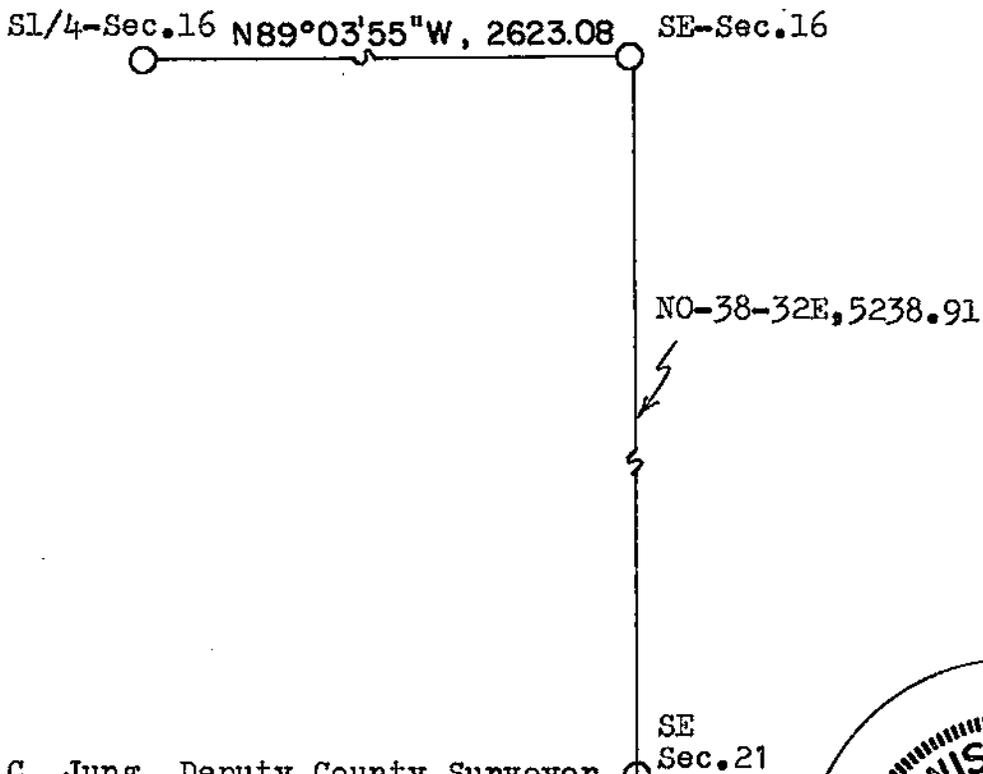

I, William C. Jung, Deputy County Surveyor, SE Sec. 21
 HEREBY CERTIFY THAT THE CORNER LOCATION SHOWN ON THIS RECORD WAS DETERMINED BY ME OR UNDER MY DIRECTION AND CONTROL AND THAT THIS U. S. PUBLIC LAND SURVEY MONUMENT RECORD IS CORRECT AND COMPLETE TO THE BEST OF MY KNOWLEDGE AND BELIEF.

William C. Jung
 Signature

2/5/86
 Date



Seal