


## U. S. PUBLIC LAND SURVEY MONUMENT RECORD

SECTION 16 T 17 N, R 6 W, TOWN OF HAMILTON  
 LA CROSSE COUNTY

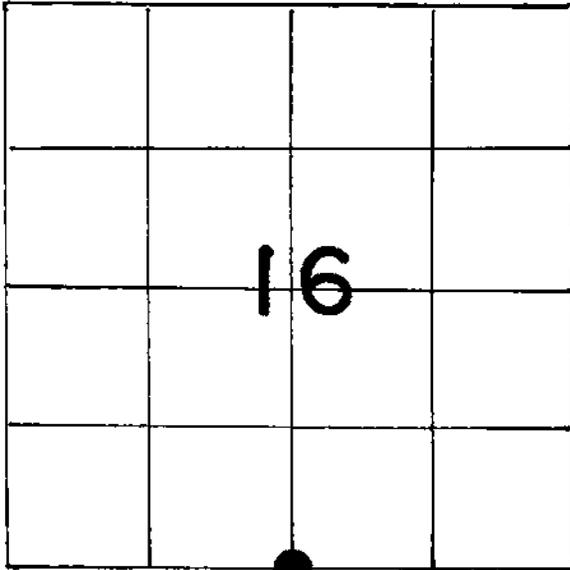

LOCATION OF LANDMARK

WISCONSIN COORDINATE SYSTEM
North
East
Theta Angle
Horiz. Order
Vert. Order
TYPE OF LANDMARK
BERNTSEN
BEARINGS ARE REFERENCED TO
assumed

Crew: William C. Jung      Witness: Kurt Wiegert  
 Perry Dahl

5/16/85  
 Describe any record evidence, monument evidence, testimonial evidence or any other material evidence you considered and whether the monument was found or restored through acceptance of an obliterated evidence location.

I found what I believe to be the original remains of an original government bearing tree. I set the corner using the rotted stump that I found. The stump is at a magnetic azimuth of 123° and a distance of 9.1' from the Berntsen that I set at the corner. I had two D.N.R. foresters examine parts of the stump and both said that it was an oak. I then ran a random brush line to the North to the top of the ridge. (Continued below)  
 Describe or show any material discrepancy between the location of the restored corner and that of the corner previously restored or reestablished.

None known.


Continued:

The blaze mark was rotted but still evident on the NW side of the rotted stump. I dug and searched for evidence of the original post but found none.

RECORD OF DURABLE WITNESS MONUMENTS

NO	DESCRIPTION	BEARING	DISTANCE
1	9" DOUBLE-BLAZED POPLAR TREE WITH P.K. NAIL	S43°W	20.01'
2	7" DOUBLE-BLAZED POPLAR TREE WITH P.K. NAIL	S41°E	5.24'
4	10" DOUBLE-BLAZED POPLAR TREE WITH P.K. NAIL	N42°E	42.16'
3	8" DOUBLE-BLAZED POPLAR TREE WITH P.K. NAIL	N3°E	40.46'


(Each distance is to a P.K. nail in a hack. All bearings are magnetic.)

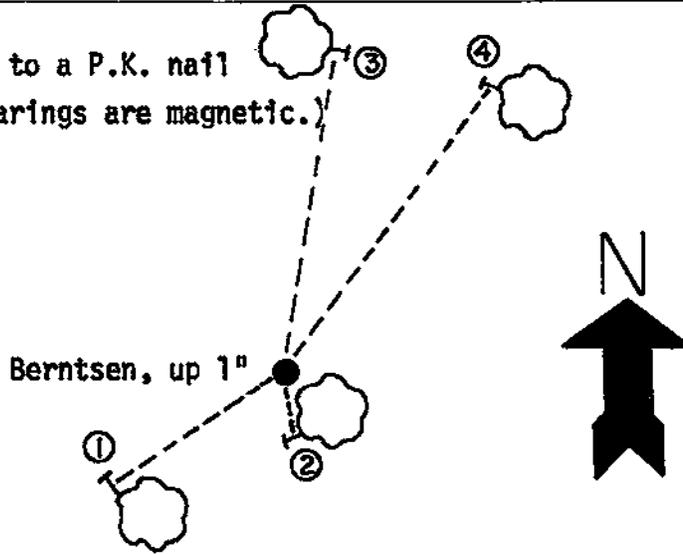

PLAN VIEW DRAWING OF REFERENCE TIES

MAP SHOWING DISTANCE AND DIRECTION TO OTHER PUBLIC LAND SURVEY CORNERS USED FOR REESTABLISHING THE CORNER


(Not to scale)

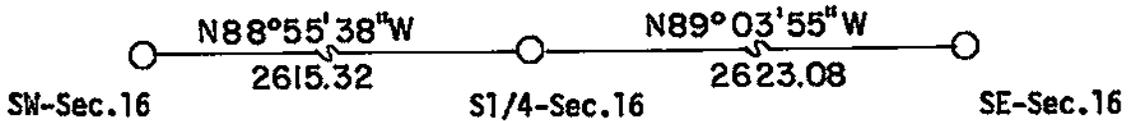

I, William C. Jung, Deputy County Surveyor,  
 HEREBY CERTIFY THAT THE CORNER LOCATION SHOWN ON THIS RECORD  
 WAS DETERMINED BY ME OR UNDER MY DIRECTION AND CONTROL AND  
 THAT THIS U. S. PUBLIC LAND SURVEY MONUMENT RECORD IS CORRECT  
 AND COMPLETE TO THE BEST OF MY KNOWLEDGE AND BELIEF.

William C. Jung  
 Signature

2/4/86  
 Date

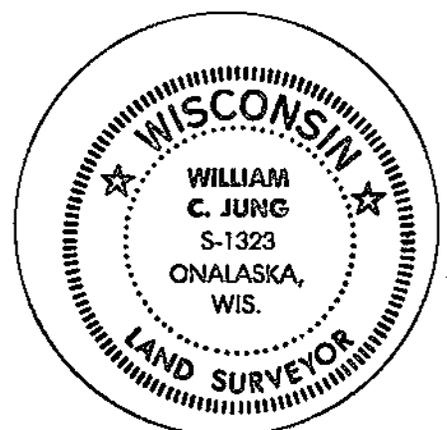

Seal