


21706162000

U. S. PUBLIC LAND SURVEY MONUMENT RECORD

SECTION 15 T 17 N, R 6 W, TOWN OF HAMILTON

LA CROSSE COUNTY

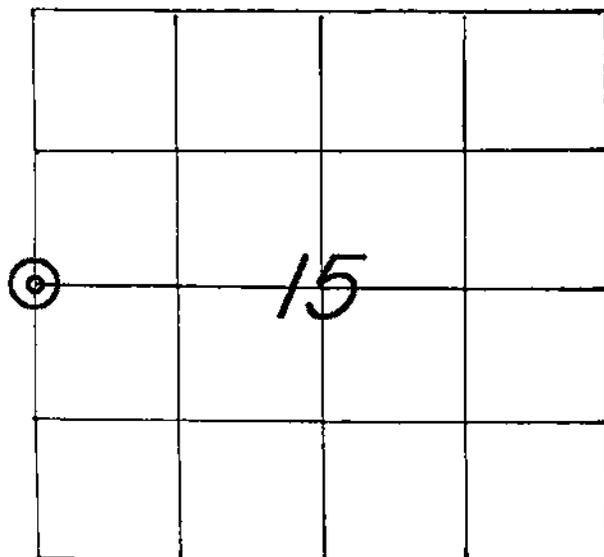

LOCATION OF LANDMARK

CREW: WILLIAM C. JUNG
 PETER F. FOLLANSBEE
 DATE: 2/28/2006

WISCONSIN COORDINATE SYSTEM

North 712,478.773East 1,680,955.283

Theta Angle

Horiz. Order

Vert. Order

DATUM: 1983('91)

TYPE OF LANDMARK

3/4" IRON BAR WITH A RED PLASTIC CAP.

BEARINGS ARE REFERENCED TO

GRID NORTH AS PER SECTION DATA.

Describe any record evidence, monument evidence, testimonial evidence or any other material evidence you considered and whether the monument was found or restored through acceptance of an obliterated evidence location.


We fd. an iron bar at this corner as set by Chris Fechner. He set it at the single proportionate position. I agree with his corner location. We set a red plastic cap on the bar and tied it off. A sign and post were set nearby. The bar falls on a grassy sidehill.

Describe or show any material discrepancy between the location of the restored corner and that of the corner previously restored or reestablished.


NONE KNOWN.

RECORD OF DURABLE WITNESS MONUMENTS

NO	DESCRIPTION	GRID BEARINGS	GROUND DIST.'S
		BEARING	DISTANCE
1	SET A 3/4"x30" IRON BAR 6' SOUTH OF GRAVEL RD. ♀	N 16°23'38" W	470.21 FT.
2	EX. IRON BAR IN THE BRUSHY CREEK BOTTOMS	N 00°24'33" E	327.41 FT.
3	SET A 3/4"x30" IRON BAR 5' SOUTH OF GRAVEL RD. ♀	N 16°03'39" E	461.96 FT.
4	EX. 3/4" IRON BAR NEAR THE EDGE OF THE WOODS	S 00°25'53" W	176.53 FT.

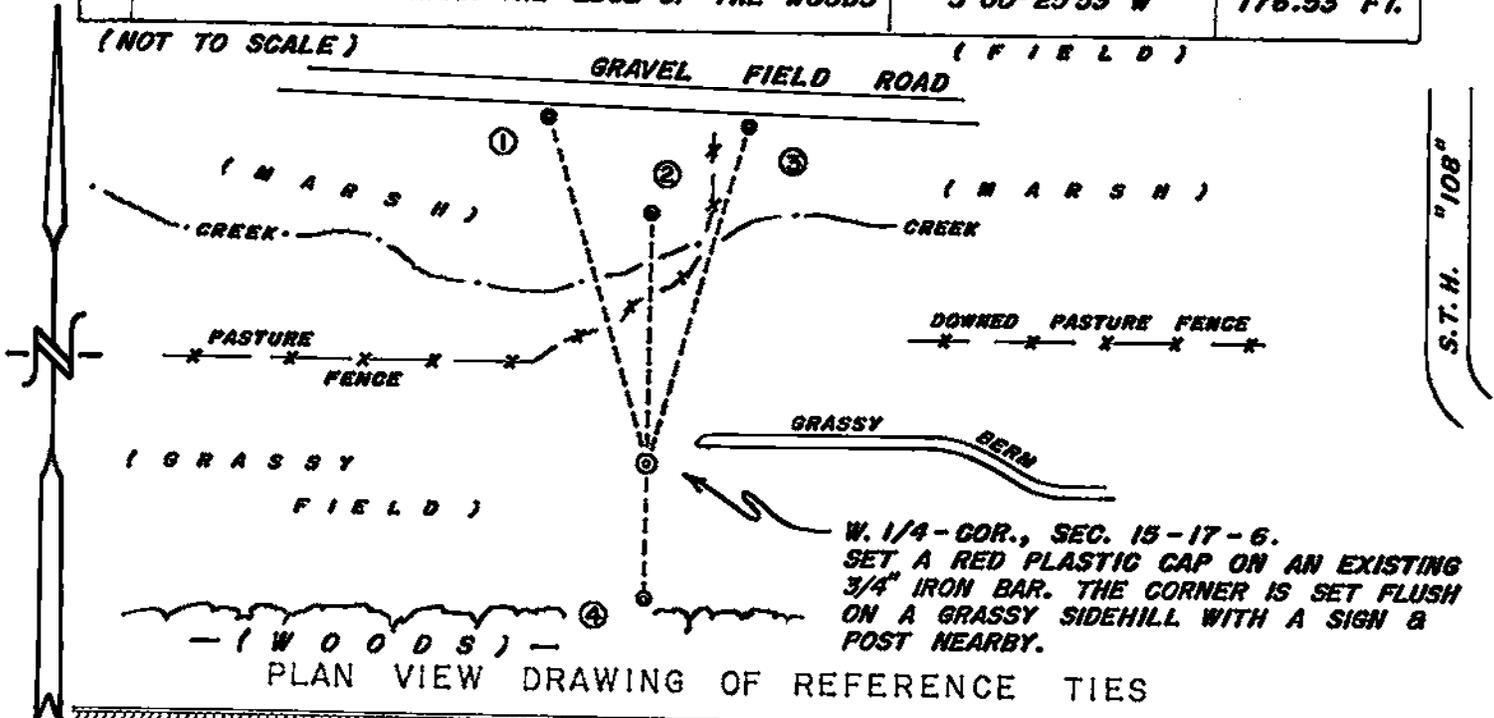


MAP SHOWING DISTANCE AND DIRECTION TO OTHER PUBLIC LAND SURVEY CORNERS USED FOR REESTABLISHING THE CORNER

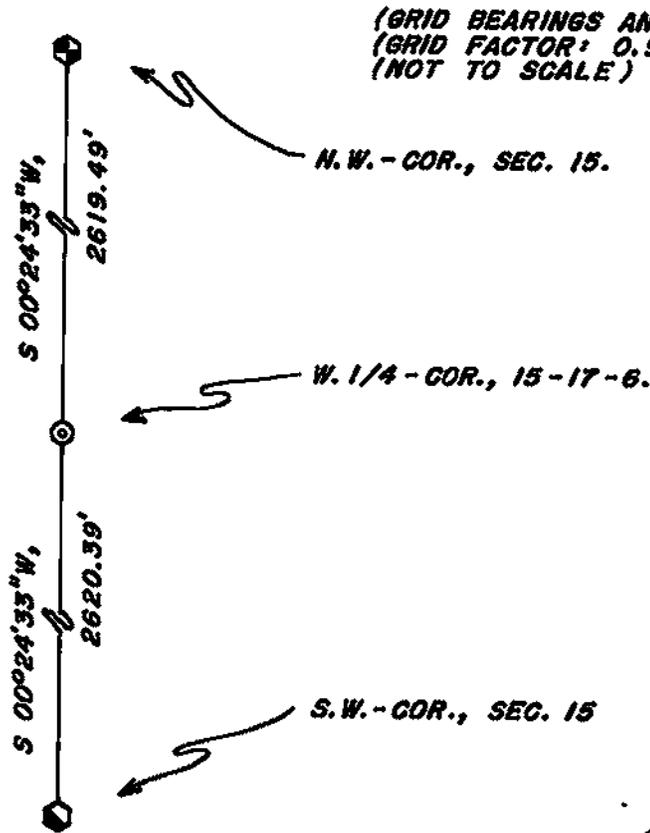

I, WILLIAM C. JUNG, COUNTY SURVEYOR
HEREBY CERTIFY THAT THE CORNER LOCATION SHOWN ON THIS RECORD WAS DETERMINED BY ME OR UNDER MY DIRECTION AND CONTROL AND THAT THIS U. S. PUBLIC LAND SURVEY MONUMENT RECORD IS CORRECT AND COMPLETE TO THE BEST OF MY KNOWLEDGE AND BELIEF.

William C. Jung 5/1/06
Signature Date

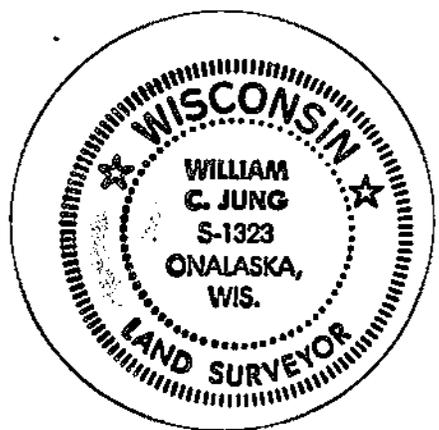

Seal