


## U. S. PUBLIC LAND SURVEY MONUMENT RECORD

SECTION 16 T 17 N, R 6 W, TOWN OF HAMILTON

LA CROSSE COUNTY

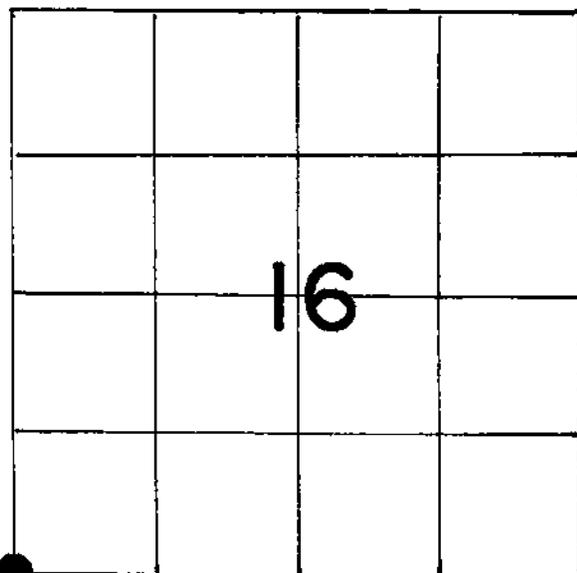

LOCATION OF LANDMARK

Crew: William Jung  
 Perry Dahl  
 5/13/85

WISCONSIN COORDINATE SYSTEM
North
East
Theta Angle
Horiz. Order
Vert. Order
TYPE OF LANDMARK
BERNTSEN
BEARINGS ARE REFERENCED TO
Assumed

Describe any record evidence, monument evidence, testimonial evidence or any other material evidence you considered and whether the monument was found or restored through acceptance of an obliterated evidence location.

After traversing out and computing portions of Sections 20 and 21 and the section line between Sections 16 and 17, I set the corner at a computed location so as to fit the bulk of the field evidence. I set a Berntsen monument at the corner on a steep sidehill.


Describe or show any material discrepancy between the location of the restored corner and that of the corner previously restored or reestablished.

None known.

RECORD OF DURABLE WITNESS MONUMENTS

NO	DESCRIPTION	BEARING	DISTANCE
1	P.K. NAIL IN DOUBLE-BLAZED 16" OAK TREE	N56°W	17.01'
2	P.K. NAIL IN DOUBLE-BLAZED 15" MAPLE	N75°W	17.26'
3	P.K. NAIL IN DOUBLE-BLAZED 16" OAK TREE	S2°E	17.5'
4	P.K. NAIL IN 4" DOUBLE-BLAZED MAPLE	N40°E	11.15'


(Each distance is to a P.K. nail in a hack on the side of the tree.  
All bearings are magnetic using a hand compass.)

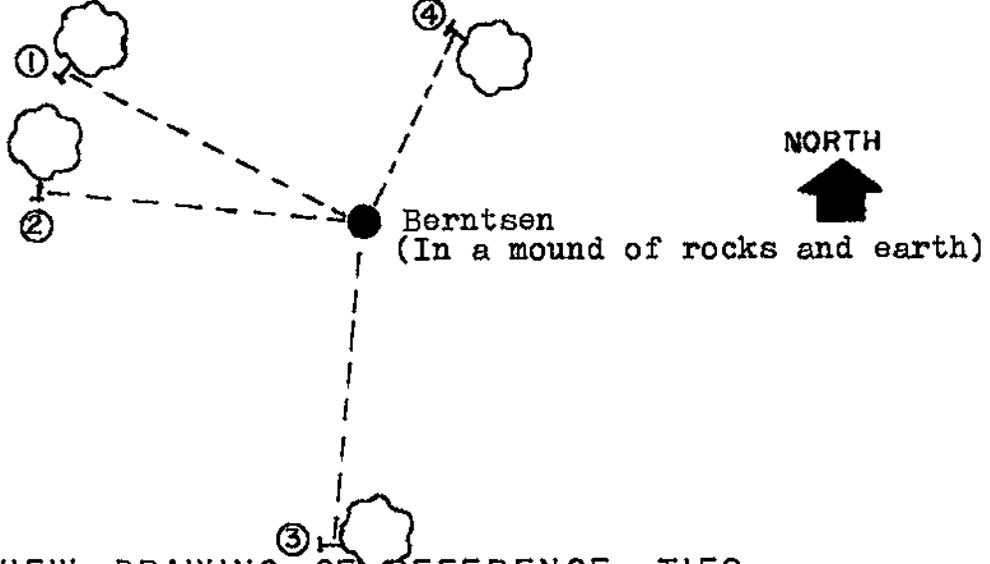

PLAN VIEW DRAWING OF REFERENCE TIES

MAP SHOWING DISTANCE AND DIRECTION TO OTHER PUBLIC LAND SURVEY CORNERS USED FOR REESTABLISHING THE CORNER

(Not to scale)

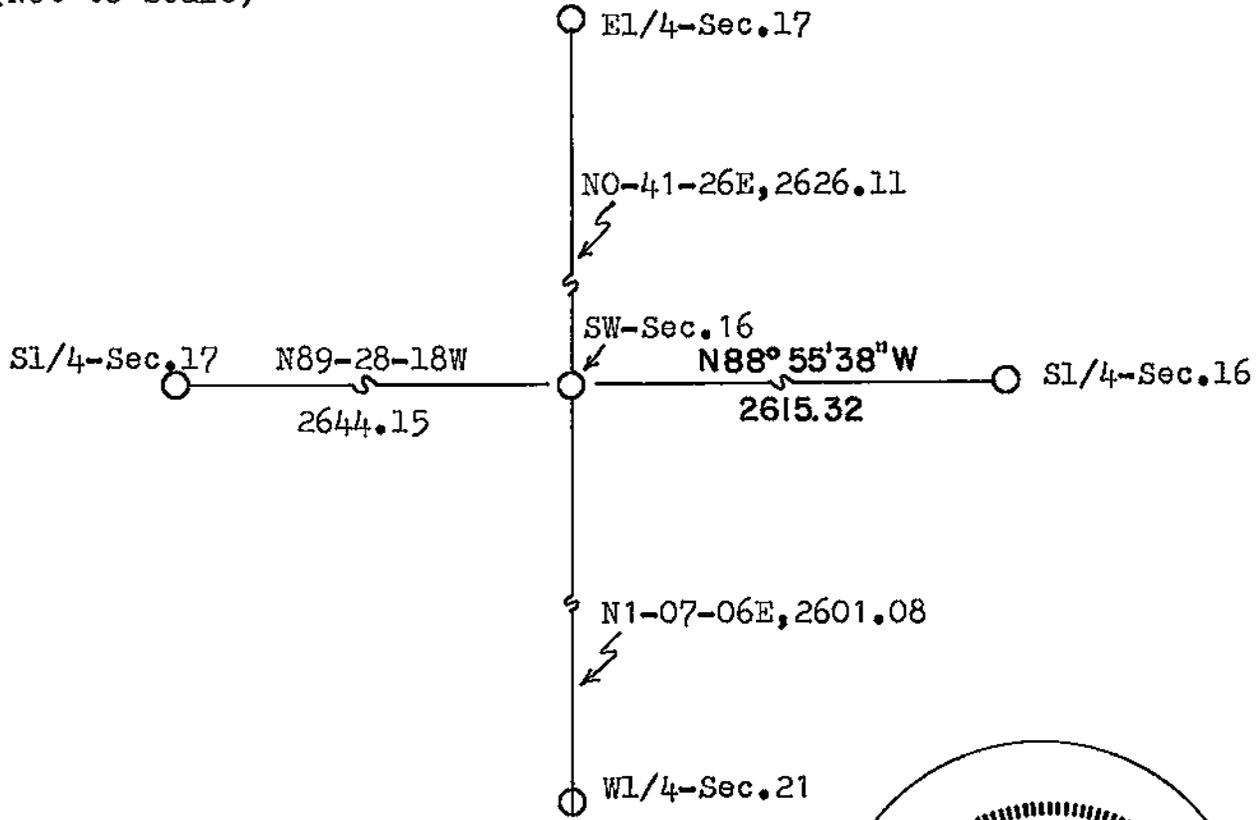

I, William C. Jung, Deputy County Surveyor,  
HEREBY CERTIFY THAT THE CORNER LOCATION SHOWN ON THIS RECORD  
WAS DETERMINED BY ME OR UNDER MY DIRECTION AND CONTROL AND  
THAT THIS U. S. PUBLIC LAND SURVEY MONUMENT RECORD IS CORRECT  
AND COMPLETE TO THE BEST OF MY KNOWLEDGE AND BELIEF.

William C. Jung  
Signature

2/5/86  
Date



Seal