


21706172000

## U. S. PUBLIC LAND SURVEY MONUMENT RECORD

SECTION 17 T 17 N, R 6 W, TOWN OF HAMILTON

LA CROSSE COUNTY

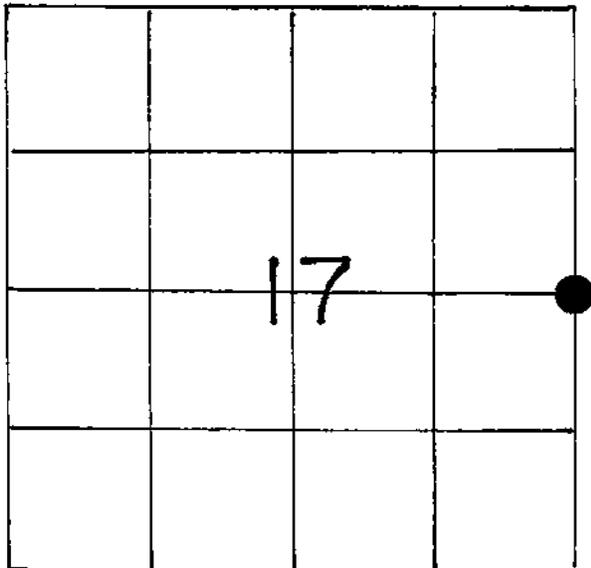

LOCATION OF LANDMARK

Crew: William C. Jung Crew: William C. Jung  
 Perry Dahl Peter Fellasbee  
 4/29/85 7/7/08

WISCONSIN COORDINATE SYSTEM
North
East
Theta Angle
Horiz. Order
Vert. Order
TYPE OF LANDMARK
BERNTSEN
BEARINGS ARE REFERENCED TO
Assumed

Describe any record evidence, monument evidence, testimonial evidence or any other material evidence you considered and whether the monument was found or restored through acceptance of an obliterated evidence location.


After traversing the East line of Section 17, I set the corner at a computed location that fits the evidence found along the East line. I set a Berntsen at the corner.

Describe or show any material discrepancy between the location of the restored corner and that of the corner previously restored or reestablished.

None known.

RECORD OF DURABLE WITNESS MONUMENTS


NO	DESCRIPTION	BEARING	DISTANCE
1	SET 1/2" REBAR	South <sub>+</sub>	59.81'
2	P.K. NAIL IN 15" DOUBLE-BLAZED CHERRY TREE	1.5' E. of fence	17.78'
3	CORNER OF OLD WINDMILL	109' E. of fence	177.5'
4	Set nail on West side of 17" double blazed oak	North <sub>+</sub>	12.83'

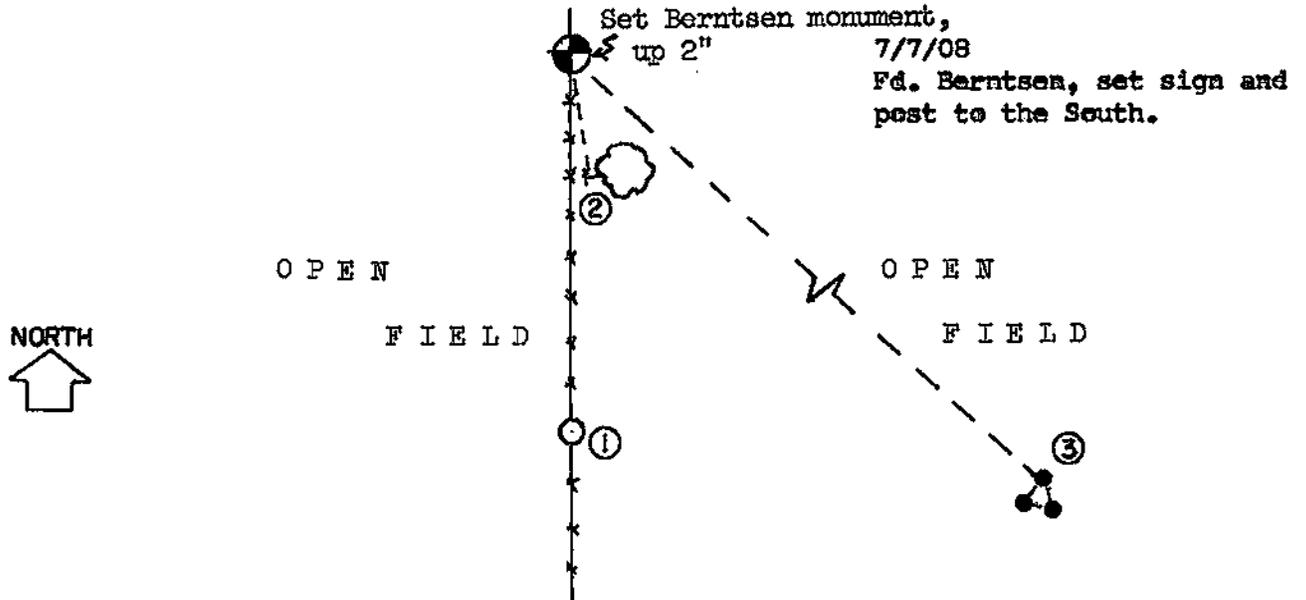

PLAN VIEW DRAWING OF REFERENCE TIES

MAP SHOWING DISTANCE AND DIRECTION TO OTHER PUBLIC LAND SURVEY CORNERS USED FOR REESTABLISHING THE CORNER

(Not to scale)

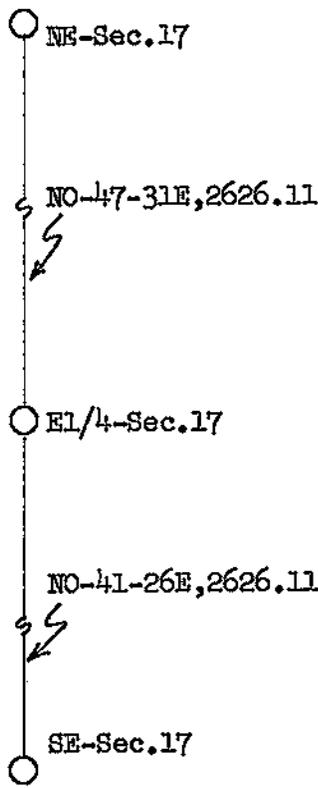


I, William C. Jung, Deputy County Surveyor,  
HEREBY CERTIFY THAT THE CORNER LOCATION SHOWN ON THIS RECORD  
WAS DETERMINED BY ME OR UNDER MY DIRECTION AND CONTROL AND  
THAT THIS U. S. PUBLIC LAND SURVEY MONUMENT RECORD IS CORRECT  
AND COMPLETE TO THE BEST OF MY KNOWLEDGE AND BELIEF.

William C. Jung  
Signature

2/4/86  
Date

Revised: 11/12/08 *WCF*

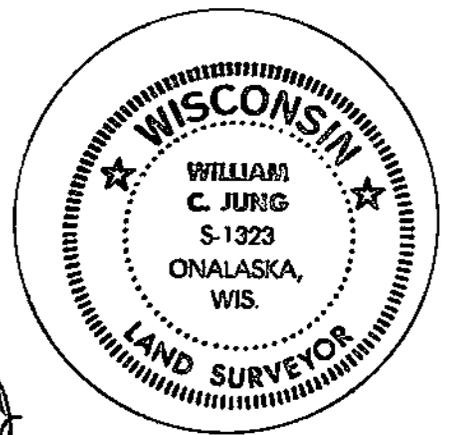

Seal