


21706190000

U. S. PUBLIC LAND SURVEY MONUMENT RECORD

SECTION 30 T 17 N, R 6 W, TOWN OF HAMILTON
LA CROSSE COUNTY

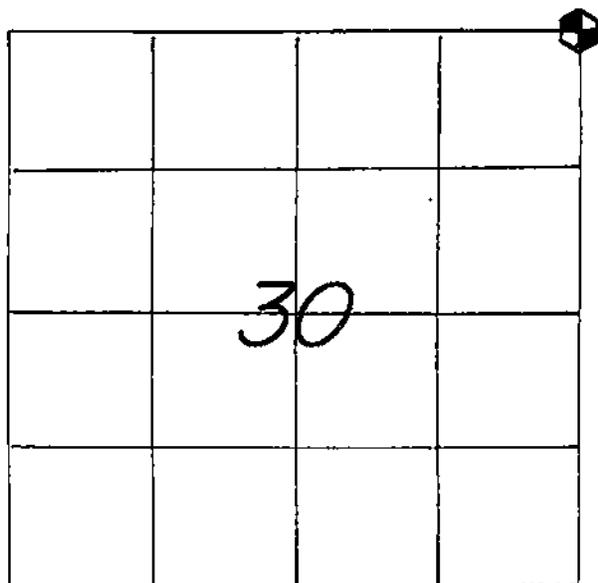

WISCONSIN COORDINATE SYSTEM
North
East
Theta Angle
Horiz. Order
Vert. Order
TYPE OF LANDMARK
<i>BRASS CAP LUNDE MARKER.</i>
BEARINGS ARE REFERENCED TO

LOCATION OF LANDMARK
 CREW: WILLIAM C. JUNG
 PETER F. FOLLANSBEE
 DATE: 7/08/1998

Describe any record evidence, monument evidence, testimonial evidence or any other material evidence you considered and whether the monument was found or restored through acceptance of an obliterated evidence location.


I found an iron pipe at the old fence corner that had been used in previous survey work. I accepted the corner as the best available evidence of the original government corner position. I replaced the iron pipe with a Lunde marker.

Describe or show any material discrepancy between the location of the restored corner and that of the corner previously restored or reestablished.

None known.

RECORD OF DURABLE WITNESS MONUMENTS

NO	DESCRIPTION	BEARING	DISTANCE
1	NAIL IN N.W.-SIDE 13" HICKORY, 1.5' WEST OF FENCE	SOUTHERLY ±	6.95 FT.
2	NAIL IN N.W.-SIDE 8" HICKORY, 9' EAST OF FENCE	N.'EASTERLY ±	29.54 FT.
3	^{PK} NAIL IN N.W.-SIDE 10" HICKORY, 10.7' EAST OF FENCE	N.'EASTERLY ±	20.30 FT.
4	NAIL IN W.-SIDE 18" OAK, 2' EAST OF FENCE	SOUTHERLY ±	26.56 FT.

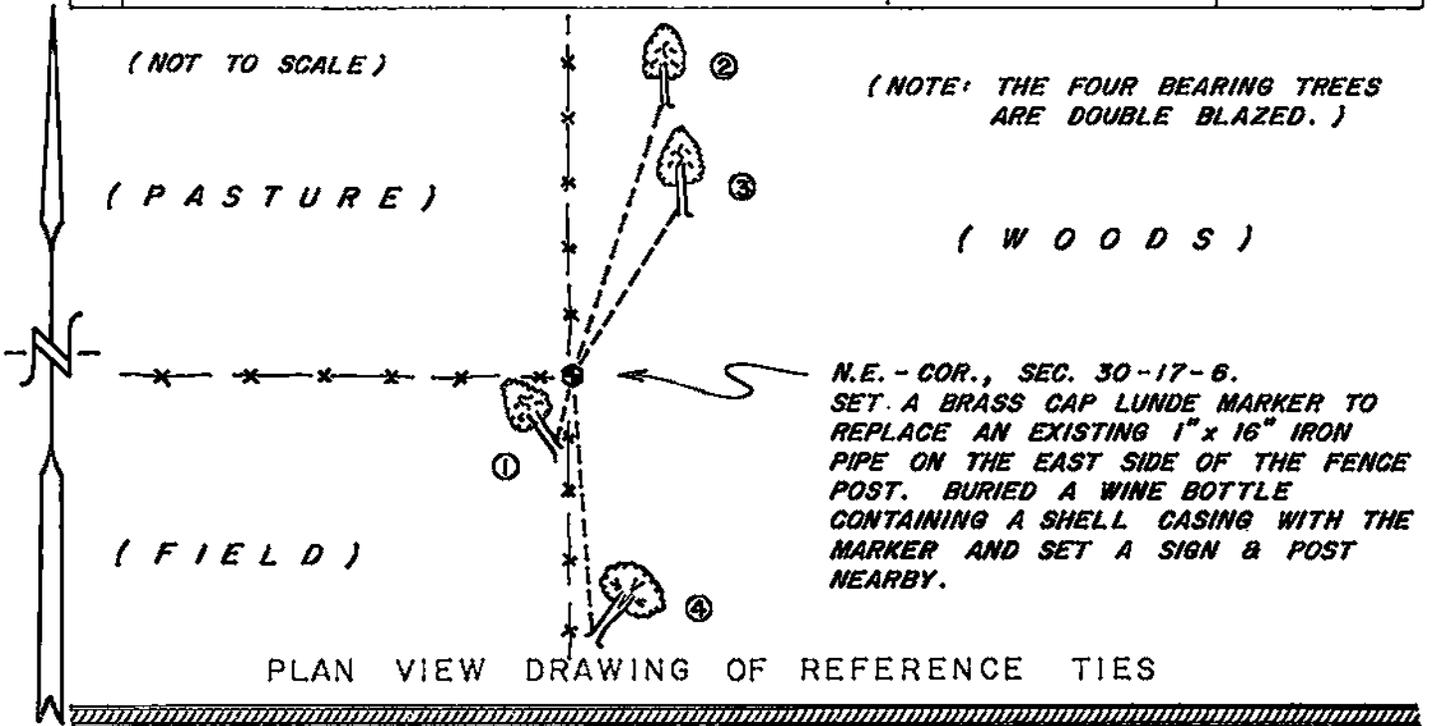

MAP SHOWING DISTANCE AND DIRECTION TO OTHER PUBLIC LAND SURVEY CORNERS USED FOR REESTABLISHING THE CORNER

No section measurements were made by me at this time. The location of this corner was confirmed by others with their section work.

I, WILLIAM C. JUNG, COUNTY SURVEYOR
 HEREBY CERTIFY THAT THE CORNER LOCATION SHOWN ON THIS RECORD WAS DETERMINED BY ME OR UNDER MY DIRECTION AND CONTROL AND THAT THIS U. S. PUBLIC LAND SURVEY MONUMENT RECORD IS CORRECT AND COMPLETE TO THE BEST OF MY KNOWLEDGE AND BELIEF.

William C. Jung
 Signature

3/24/99
 Date



Seal