


21706190020

## U. S. PUBLIC LAND SURVEY MONUMENT RECORD

SECTION 19 T 17 N, R 6 W, TOWN OF HAMILTON

LA CROSSE COUNTY

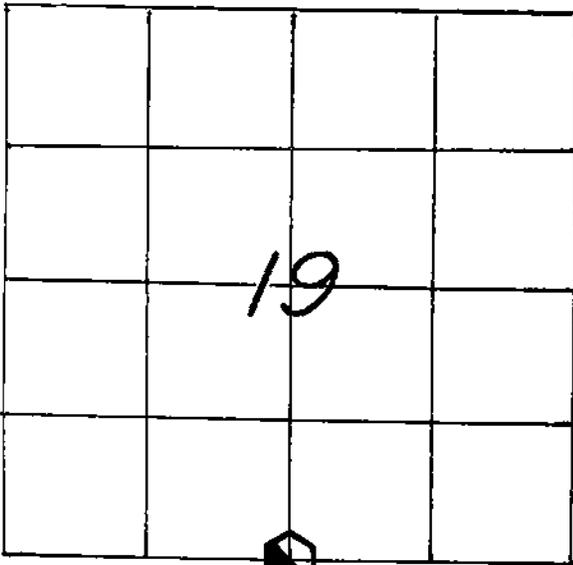

LOCATION OF LANDMARK

CREW: WILLIAM G. JUNG  
 PETER F. FOLLANSBEE  
 DATE: 6/02/2005

## WISCONSIN COORDINATE SYSTEM

North 704,737.772

East 1,667,744.760

Theta Angle

Horiz. Order

Vert. Order

DATUM: 1983('91)

TYPE OF LANDMARK

30" ALUMINUM BERNTSEN MARKER.

BEARINGS ARE REFERENCED TO

GRID NORTH AS PER SECTION DATA.

Describe any record evidence, monument evidence, testimonial evidence or any other material evidence you considered and whether the monument was found or restored through acceptance of an obliterated evidence location.


After resurveying the South line of Section 19 and evaluating all the field evidence, I decided to set the corner "by law" and placed a Berntsen marker at the single proportionate position.

Describe or show any material discrepancy between the location of the restored corner and that of the corner previously restored or reestablished.


**NONE KNOWN.**

RECORD OF DURABLE WITNESS MONUMENTS

NO	DESCRIPTION	MAGNETIC BEARING	DISTANCE
1	SET A NAIL IN S.E.-SIDE OF A 12" WHITE OAK	S 51° W	55.08 FT.
2	SET A NAIL IN S.E.-SIDE OF A 5" HICKORY	S 67° W	12.95 FT.
3	SET A NAIL IN S.E.-SIDE OF A 20" OAK	N 38° E	37.66 FT.
4	SET A NAIL IN N.W.-SIDE OF A 10" WHITE OAK	N 53° E	64.70 FT.

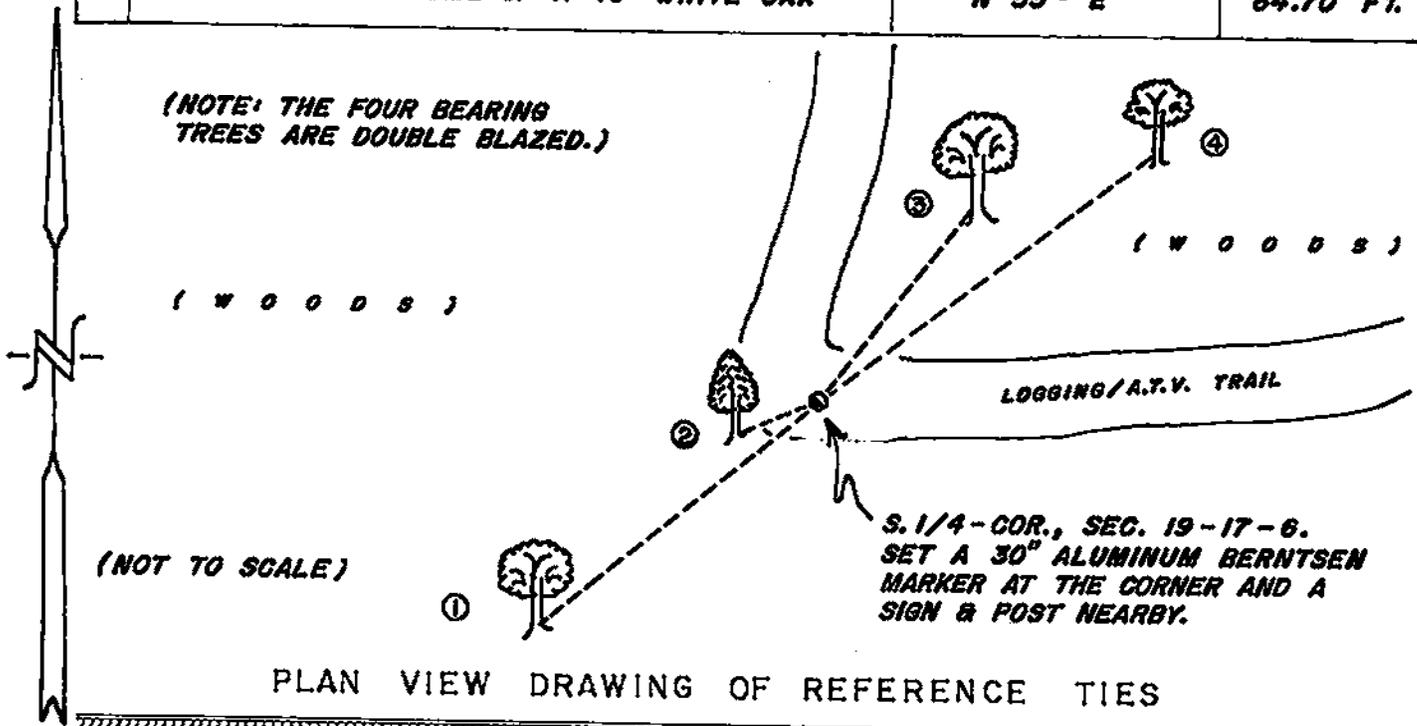

MAP SHOWING DISTANCE AND DIRECTION TO OTHER PUBLIC LAND SURVEY CORNERS USED FOR REESTABLISHING THE CORNER

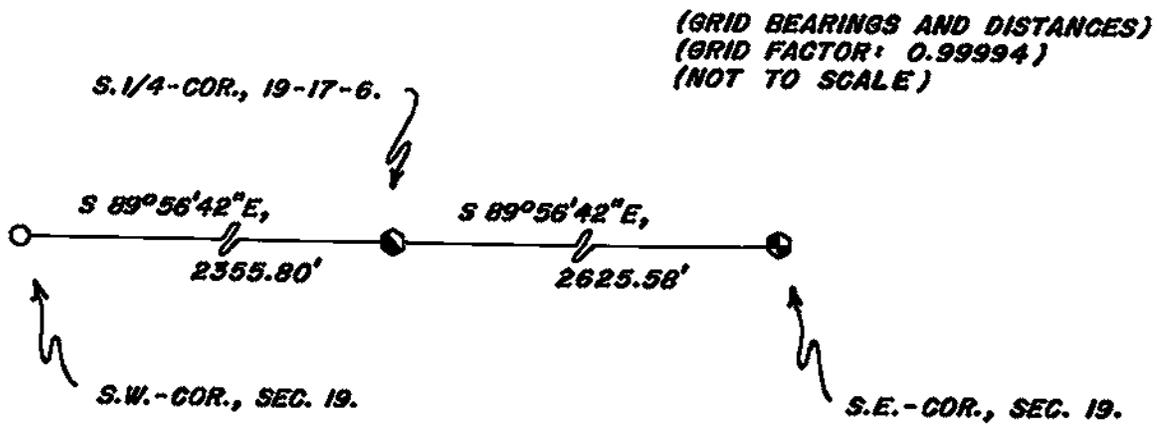

I, WILLIAM C. JUNG, COUNTY SURVEYOR  
HEREBY CERTIFY THAT THE CORNER LOCATION SHOWN ON THIS RECORD WAS DETERMINED BY ME OR UNDER MY DIRECTION AND CONTROL AND THAT THIS U. S. PUBLIC LAND SURVEY MONUMENT RECORD IS CORRECT AND COMPLETE TO THE BEST OF MY KNOWLEDGE AND BELIEF

William C. Jung                      12/5/05  
Signature                                      Date



Seal