


21706192000

## U. S. PUBLIC LAND SURVEY MONUMENT RECORD

SECTION 20 T 17 N, R 6 W, TOWN OF HAMILTON

LA CROSSE COUNTY

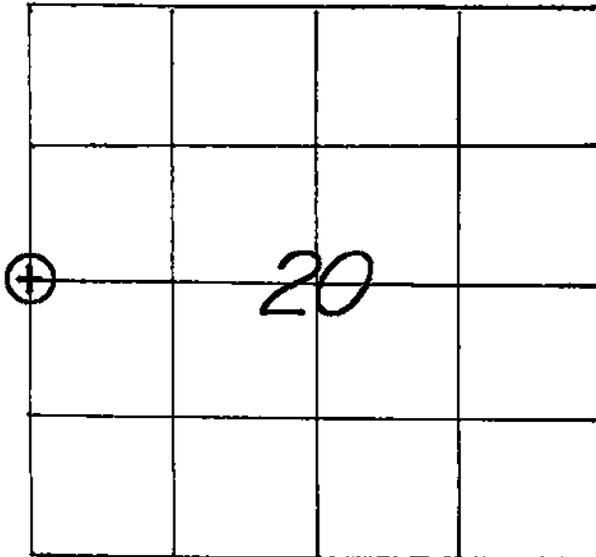

LOCATION OF LANDMARK

CREW: WILLIAM G. JUNG  
 PETER F. FOLLANSBEE  
 DATE: 5/05/2004

## WISCONSIN COORDINATE SYSTEM

North

East

Theta Angle

Horiz. Order

Vert. Order

## TYPE OF LANDMARK

3/4" x 30" IRON BAR WITH AN ALUMINUM CAP.

BEARINGS ARE REFERENCED TO

Describe any record evidence, monument evidence, testimonial evidence or any other material evidence you considered and whether the monument was found or restored through acceptance of an obliterated evidence location.

We found an iron pipe at the occupied fence corner. This pipe had been used as the corner in previous survey work. I accepted this location as the best available evidence of the original government corner position. An iron bar and cap were set in the pipe and driven down flush.

Describe or show any material discrepancy between the location of the restored corner and that of the corner previously restored or reestablished.

**NONE KNOWN.**

