


21706200000

U. S. PUBLIC LAND SURVEY MONUMENT RECORD

SECTION 20 T 17 N, R 6 W, TOWN OF HAMILTON

LA CROSSE COUNTY

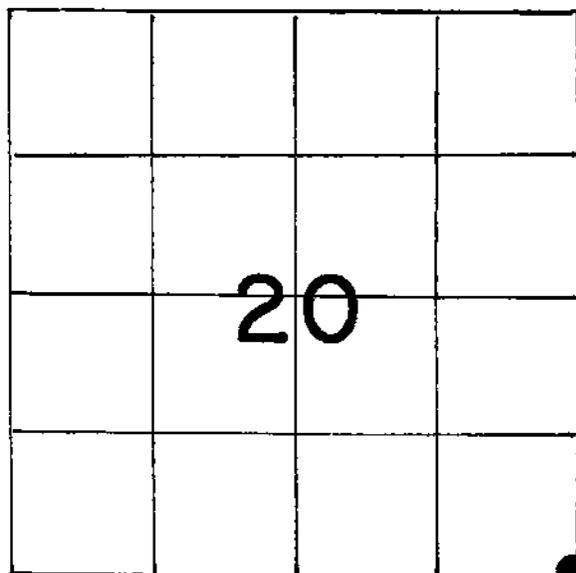

LOCATION OF LANDMARK

WISCONSIN COORDINATE SYSTEM

North

East

Theta Angle

Horiz. Order

Vert. Order

TYPE OF LANDMARK

BERNTSEN

BEARINGS ARE REFERENCED TO

Assumed

Crew: William C. Jung

Perry Dahl

5/6/85

Crew: William C. Jung

Peter Follansbee

8/24/01

Describe any record evidence, monument evidence, testimonial evidence or any other material evidence you considered and whether the monument was found or restored through acceptance of an obliterated evidence location.

I set the corner at a computed location after traversing in all four cardinal directions. This location fits the bulk of the evidence that I found.

8/24/01 - Reset the Berntsen monument. It had been knocked off plumb.


Describe or show any material discrepancy between the location of the restored corner and that of the corner previously restored or reestablished.

None known.

RECORD OF DURABLE WITNESS MONUMENTS

NO	Existing DESCRIPTION	BEARING	DISTANCE
1	SET ^{Existing} 1 1/2" IRON PIPE	N3°W	16.01' 14.88'
2	SET P.K. NAIL Existing	S3°E	17.46'
3	SET 1 1/2" IRON PIPE (gone)	S3°E	37.04'
4	P.K. NAIL FOUND (Ray Pelishek's survey pt.)	S80°42'E	101.13'


(Magnetic bearings)

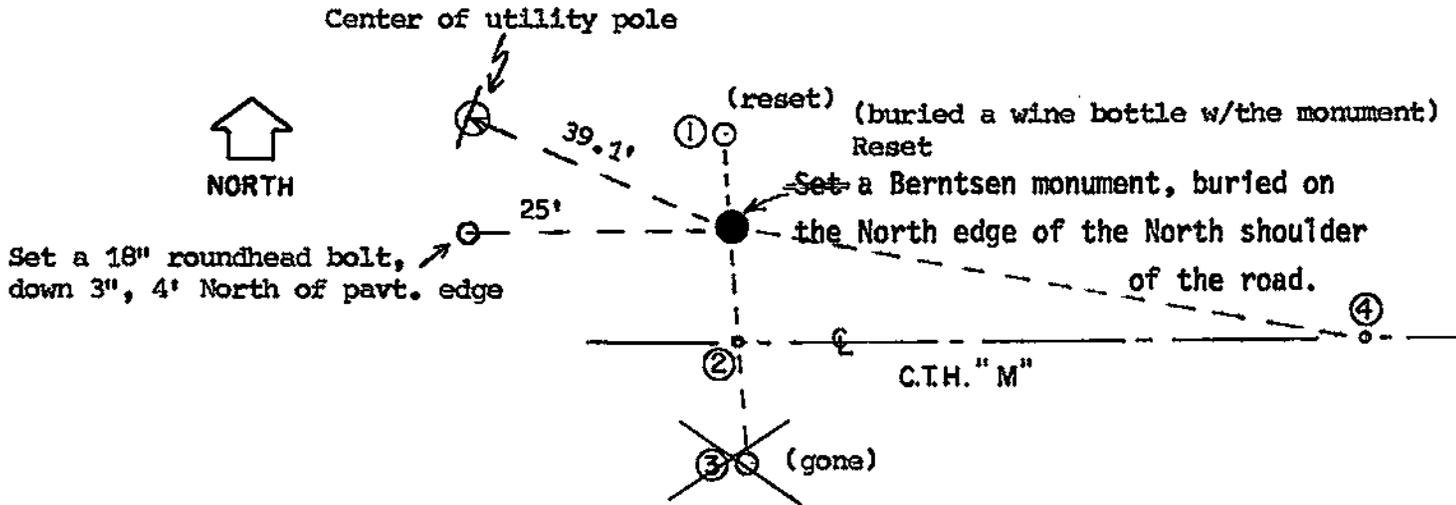

PLAN VIEW DRAWING OF REFERENCE TIES

MAP SHOWING DISTANCE AND DIRECTION TO OTHER PUBLIC LAND SURVEY CORNERS USED FOR REESTABLISHING THE CORNER

(Not to scale)

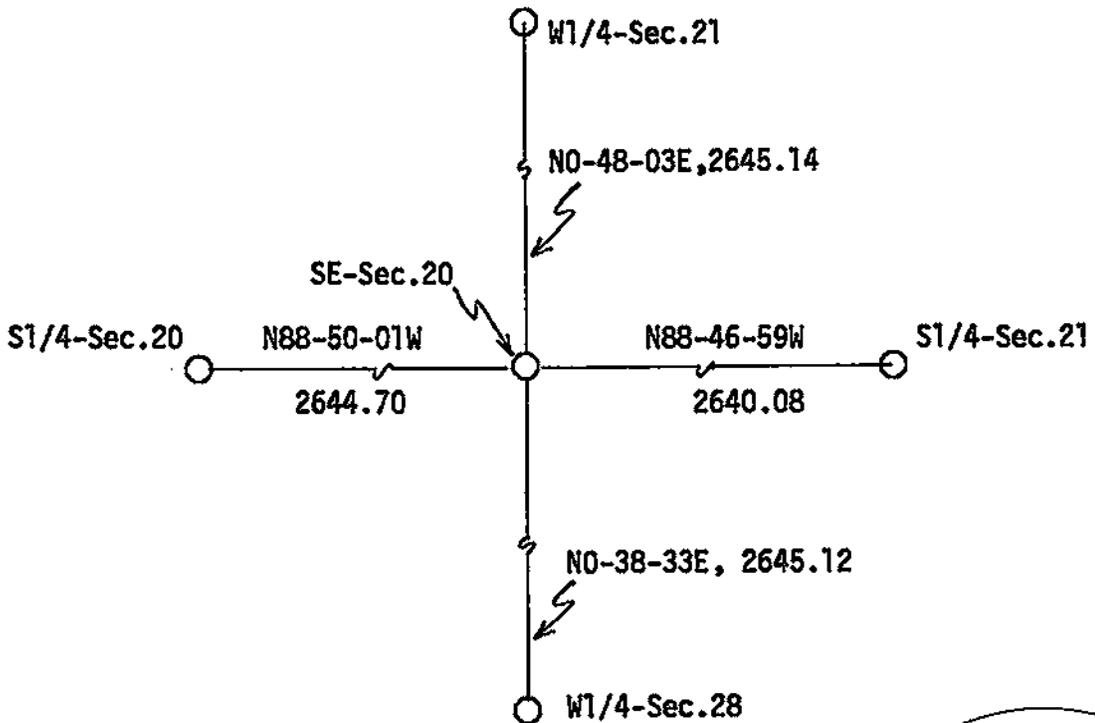

I, William C. Jung, Deputy County Surveyor.
 HEREBY CERTIFY THAT THE CORNER LOCATION SHOWN ON THIS RECORD
 WAS DETERMINED BY ME OR UNDER MY DIRECTION AND CONTROL AND
 THAT THIS U. S. PUBLIC LAND SURVEY MONUMENT RECORD IS CORRECT
 AND COMPLETE TO THE BEST OF MY KNOWLEDGE AND BELIEF.

William C. Jung 2/4/86
 Signature Date
 Revised: 4/30/02 *wey*

