


21706200020

U. S. PUBLIC LAND SURVEY MONUMENT RECORD

SECTION 20 T 17 N, R 6 W, TOWN OF HAMILTON

LA CROSSE COUNTY

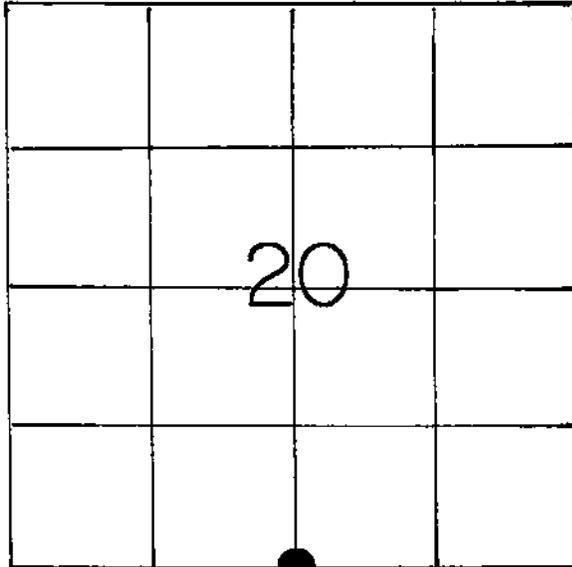

LOCATION OF LANDMARK

Crew: William C. Jung
Perry Dahl

4/29/85

WISCONSIN COORDINATE SYSTEM

North

East

Theta Angle

Horiz. Order

Vert. Order

TYPE OF LANDMARK

1 1/2" IRON PIPE

BEARINGS ARE REFERENCED TO

Assumed

Describe any record evidence, monument evidence, testimonial evidence or any other material evidence you considered and whether the monument was found or restored through acceptance of an obliterated evidence location.

After traversing in Section 20, I accepted the occupied fence corner as the best available evidence of the original government corner and monumented it with an iron pipe.


Describe or show any material discrepancy between the location of the restored corner and that of the corner previously restored or reestablished.

None known.

RECORD OF DURABLE WITNESS MONUMENTS

NO	DESCRIPTION	BEARING	DISTANCE
1	P.K. NAIL IN 9" SINGLE-BLAZED BIRCH TREE	N24°E	41.35' (slope)
2	P.K. NAIL IN 21" SINGLE-BLAZED WHITE OAK	S21°W	44.3'
3	P.K. NAIL IN 30" SINGLE-BLAZED WHITE OAK	S18°W	26.2'
4	P.K. NAIL IN 31" SINGLE-BLAZED WHITE OAK	S70°E	119.7' (slope)


(Each distance is to a P.K. nail in a hack on the side of the tree. All bearings are magnetic using a hand compass.)

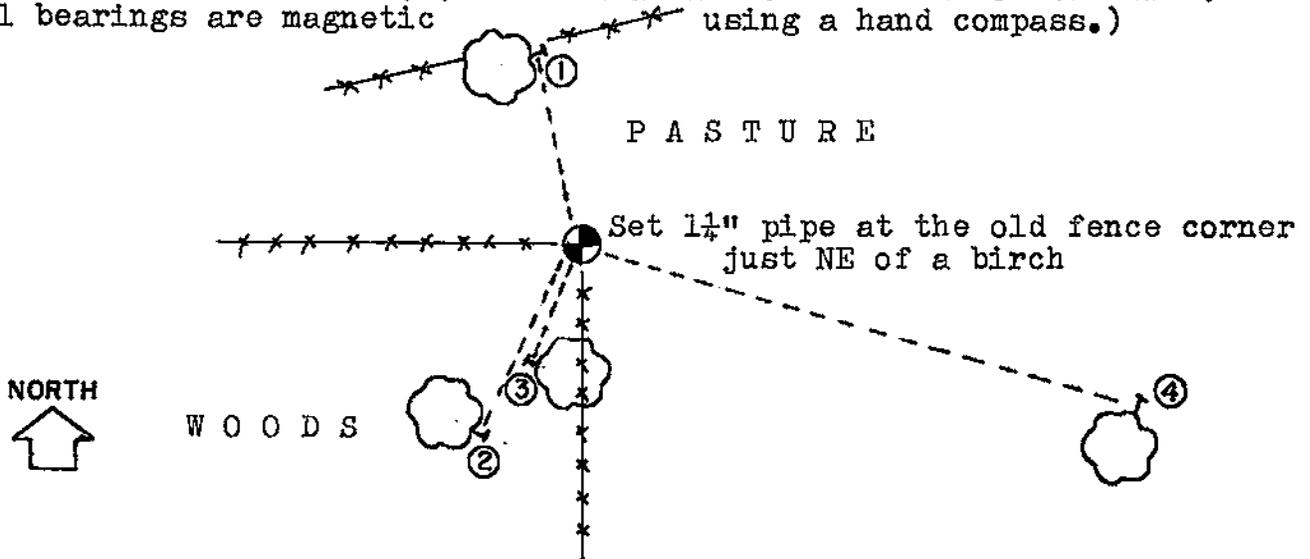

PLAN VIEW DRAWING OF REFERENCE TIES




MAP SHOWING DISTANCE AND DIRECTION TO OTHER PUBLIC LAND SURVEY CORNERS USED FOR REESTABLISHING THE CORNER

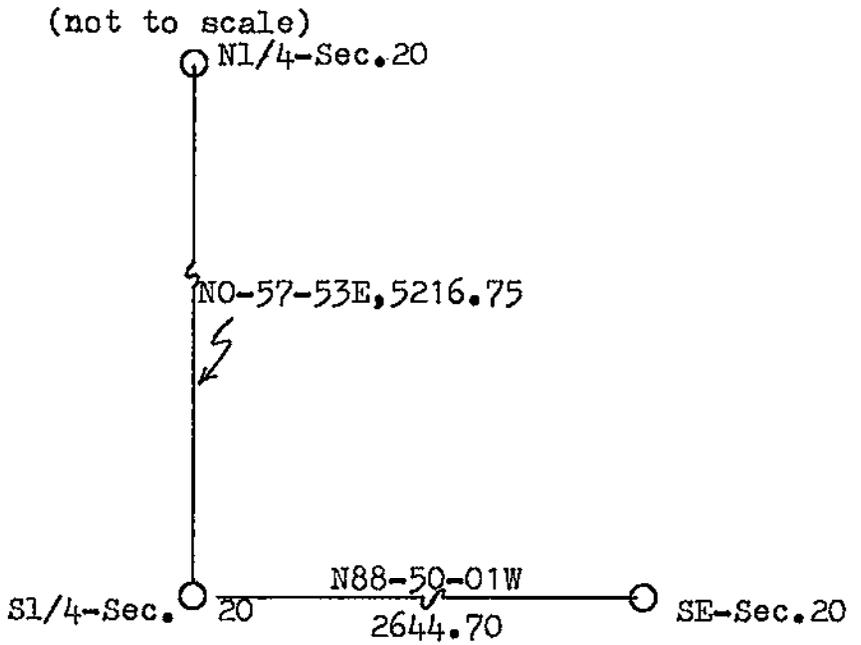

I, William C. Jung, Deputy County Surveyor,
 HEREBY CERTIFY THAT THE CORNER LOCATION SHOWN ON THIS RECORD
 WAS DETERMINED BY ME OR UNDER MY DIRECTION AND CONTROL AND
 THAT THIS U. S. PUBLIC LAND SURVEY MONUMENT RECORD IS CORRECT
 AND COMPLETE TO THE BEST OF MY KNOWLEDGE AND BELIEF.

William C. Jung 2/5/86
 Signature Date

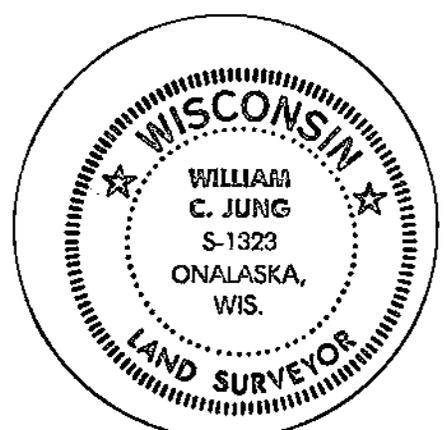

Seal