


U. S. PUBLIC LAND SURVEY MONUMENT RECORD

SECTION 20 T 17 N, R 6 W, TOWN OF HAMILTON

LA CROSSE COUNTY

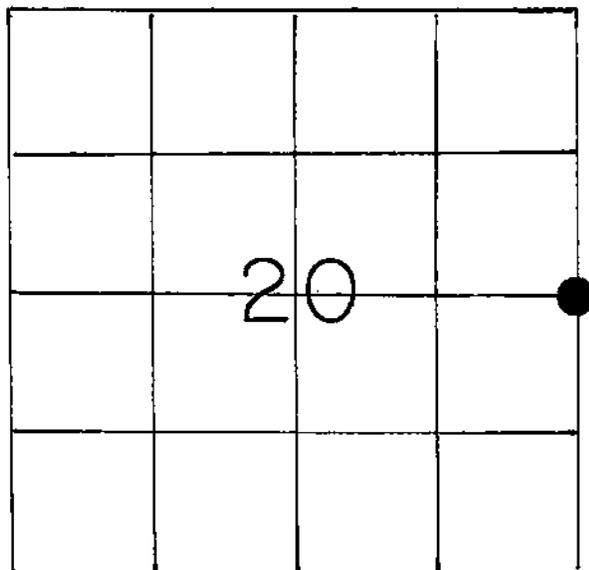

LOCATION OF LANDMARK

Crew: William C. Jung
Perry Dahl

5/1/85

Describe any record evidence, monument evidence, testimonial evidence or any other material evidence you considered and whether the monument was found or restored through acceptance of an obliterated evidence location.

After traversing out and computing portions of Sections 20, 21, and 28, I set the corner at a computed location so as to fit the proportions and field evidence found along the East lines of the SE1/4 of Section 20 and the NW1/4 of Section 28. I set a Berntsen at the corner in the existing North-South fence.

Describe or show any material discrepancy between the location of the restored corner and that of the corner previously restored or reestablished.

None known.

WISCONSIN COORDINATE SYSTEM

North

East

Theta Angle

Horiz. Order

Vert. Order

TYPE OF LANDMARK

BERNTSEN


BEARINGS ARE REFERENCED TO

Assumed

RECORD OF DURABLE WITNESS MONUMENTS

NO	DESCRIPTION	BEARING	DISTANCE
1	P.K. NAIL IN 14" DOUBLE-BLAZED ASPEN	N55°W	35.78'
2	P.K. NAIL IN 12" DOUBLE-BLAZED ASPEN	N77°W	44.38'
3	P.K. NAIL IN 14" DOUBLE-BLAZED ASPEN	N48°E	35.89'
4	P.K. NAIL IN 14" DOUBLE-BLAZED ASPEN	N34°E	18.91'


(Each distance is to a P.K. nail in a hack on the side of the tree. All bearings are magnetic using a hand compass.)

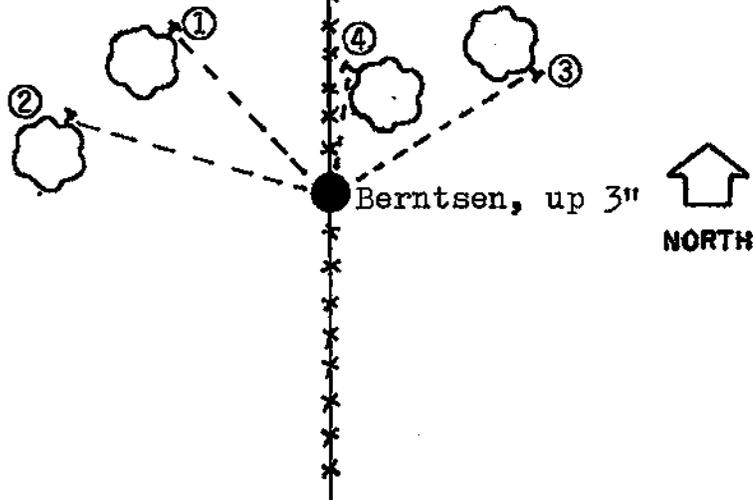

PLAN VIEW DRAWING OF REFERENCE TIES

MAP SHOWING DISTANCE AND DIRECTION TO OTHER PUBLIC LAND SURVEY CORNERS USED FOR REESTABLISHING THE CORNER


(not to scale)

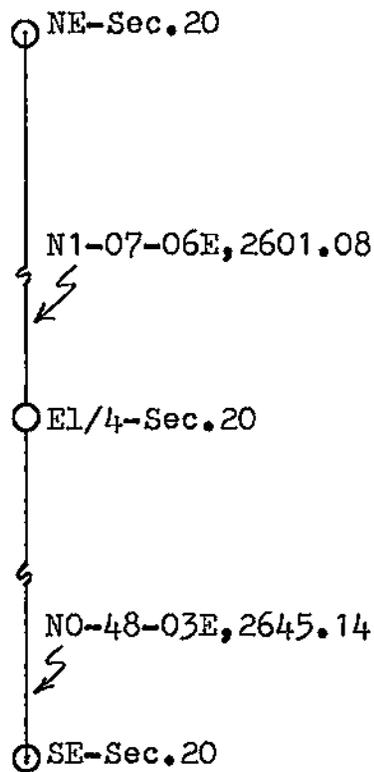

I, William C. Jung, Deputy County Surveyor,
 HEREBY CERTIFY THAT THE CORNER LOCATION SHOWN ON THIS RECORD
 WAS DETERMINED BY ME OR UNDER MY DIRECTION AND CONTROL AND
 THAT THIS U. S. PUBLIC LAND SURVEY MONUMENT RECORD IS CORRECT
 AND COMPLETE TO THE BEST OF MY KNOWLEDGE AND BELIEF.

William C. Jung
 Signature

2/5/86
 Date

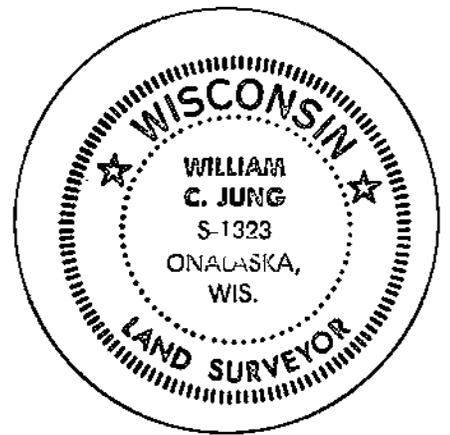

Seal