


21706210000

## U. S. PUBLIC LAND SURVEY MONUMENT RECORD

SECTION 21 T 17 N, R 6 W, TOWN OF HAMILTON

LA CROSSE COUNTY

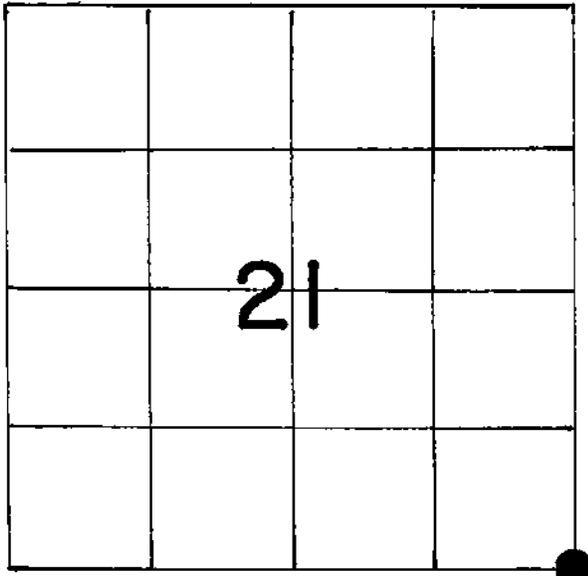

LOCATION OF LANDMARK

Crew: William C. Jung

Perry Dahl

5/1/85

Describe any record evidence, monument evidence, testimonial evidence or any other material evidence you considered and whether the monument was found or restored through acceptance of an obliterated evidence location.

In May of 1983 Dick Berg shows an existing iron bar at the corner. I found an old iron monument at the corner which fits the occupation. Mr. Miller, a local resident told me that he has lived here 42 years and that the iron has always been there. I accepted this old iron as the best available evidence of the original government corner, removed it, and replaced it with a Berntsen, up 1".

Describe or show any material discrepancy between the location of the restored corner and that of the corner previously restored or reestablished.

None known.

## WISCONSIN COORDINATE SYSTEM

North

East

Theta Angle

Horiz. Order

Vert. Order

## TYPE OF LANDMARK

BERNTSEN

BEARINGS ARE REFERENCED TO

Assumed

