


21706210020

## U. S. PUBLIC LAND SURVEY MONUMENT RECORD

SECTION 21 T 17 N, R 6 W, TOWN OF HAMILTON

LA CROSSE COUNTY

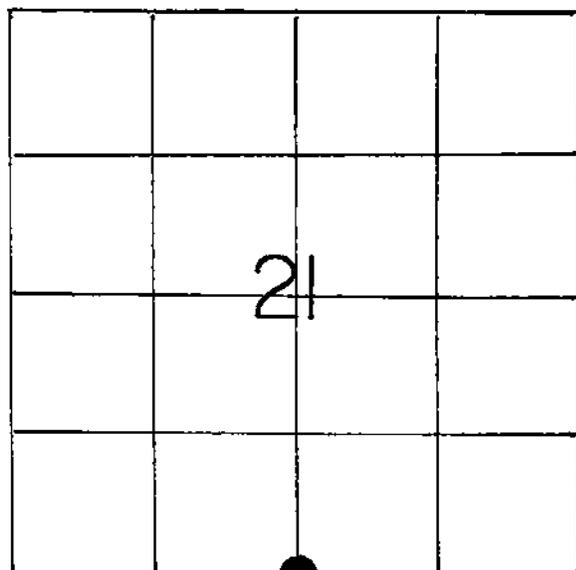

LOCATION OF LANDMARK

WISCONSIN COORDINATE SYSTEM

North

East

Theta Angle

Horiz. Order

Vert. Order

TYPE OF LANDMARK

BERNTSEN

BEARINGS ARE REFERENCED TO

Assumed

Crew: William Jung  
Perry DahlCrew: William Jung  
Peter Follansbee

4/29/85

7/8/08

Describe any record evidence, monument evidence, testimonial evidence or any other material evidence you considered and whether the monument was found or restored through acceptance of an obliterated evidence location.

After traversing in Sections 21 and 28, I accepted the occupied fence corner as the best available evidence of the original government corner and monumented it with a Berntsen monument.


Describe or show any material discrepancy between the location of the restored corner and that of the corner previously restored or reestablished.

None known.

RECORD OF DURABLE WITNESS MONUMENTS

| NO | DESCRIPTION                            | BEARING | DISTANCE |
|----|--|---------|----------|
| 1  | P.K. NAIL IN 12" DOUBLE-BLAZED CHERRY  | S88°W   | 50.86'   |
| 2  | P.K. NAIL IN 7" WALNUT TREE (unblazed) | S25°W   | 20.85'   |
| 3  | P.K. NAIL IN 6" WALNUT TREE (unblazed) | S6°W    | 30.05'   |
| 4  | SET 1 1/4' IRON PIPE                   | East±   | 33.5'    |


(All bearings are magnetic using a hand compass.)

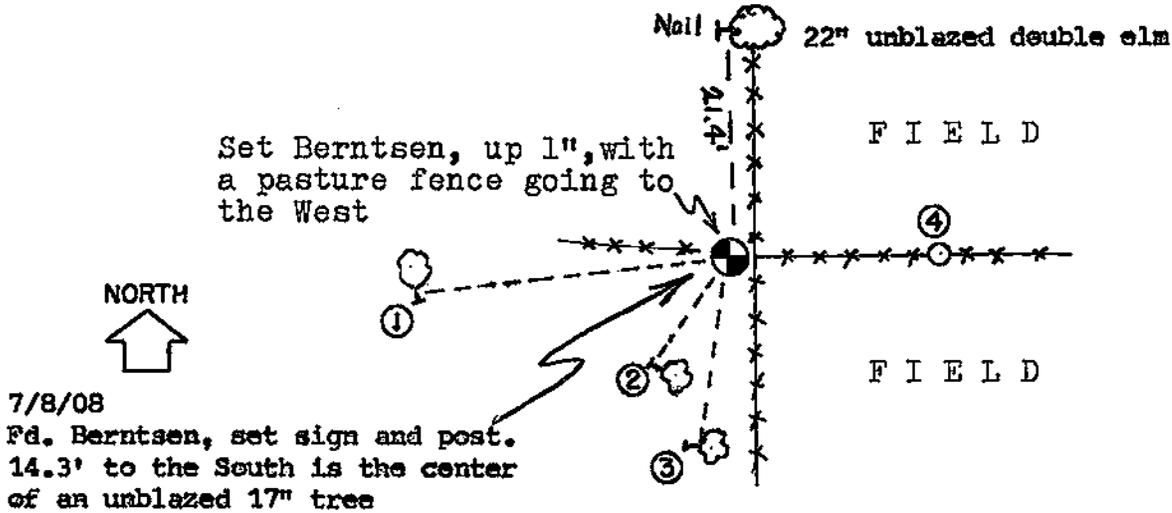

PLAN VIEW DRAWING OF REFERENCE TIES

MAP SHOWING DISTANCE AND DIRECTION TO OTHER PUBLIC LAND SURVEY CORNERS USED FOR REESTABLISHING THE CORNER


(Not to scale)

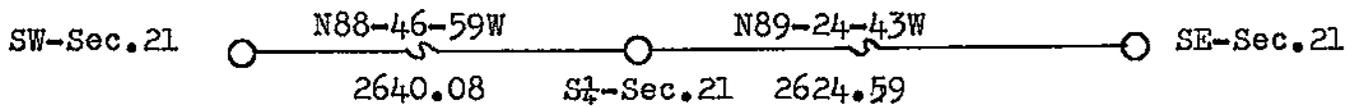

I, William C. Jung, Deputy County Surveyor,  
 HEREBY CERTIFY THAT THE CORNER LOCATION SHOWN ON THIS RECORD  
 WAS DETERMINED BY ME OR UNDER MY DIRECTION AND CONTROL AND  
 THAT THIS U. S. PUBLIC LAND SURVEY MONUMENT RECORD IS CORRECT  
 AND COMPLETE TO THE BEST OF MY KNOWLEDGE AND BELIEF.

William C. Jung  
 Signature

2/5/86  
 Date  
 Revised: 11/12/08 *wej*

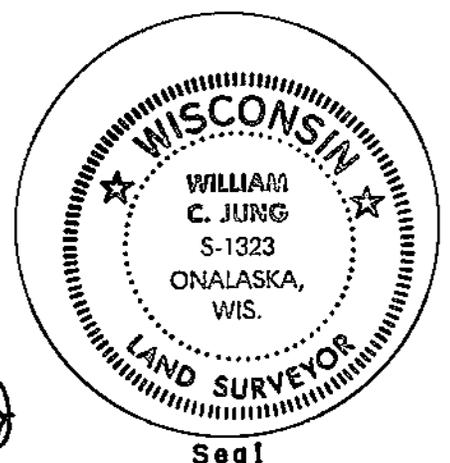

Seal