


21706212000

U. S. PUBLIC LAND SURVEY MONUMENT RECORD

SECTION 21 T 17 N, R 6 W, TOWN OF HAMILTON

LA CROSSE COUNTY

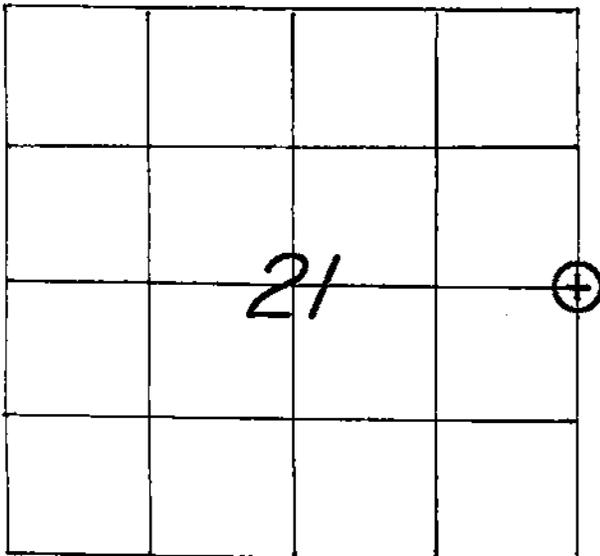

WISCONSIN COORDINATE SYSTEM

North **707,259.552**

East **1,680,955.948**

Theta Angle

Horiz. Order

Vert. Order

DATUM: **1983('91)**

TYPE OF LANDMARK

3/4" x 30" IRON BAR WITH AN ALUMINUM CAP.

BEARINGS ARE REFERENCED TO

GRID NORTH AS PER SECTION DATA.

LOCATION OF LANDMARK

CREW: **WILLIAM C. JUNG**
PETER F. FOLLANSBEE
 DATE: **2/23/2006**

Describe any record evidence, monument evidence, testimonial evidence or any other material evidence you considered and whether the monument was found or restored through acceptance of an obliterated evidence location.

I found what I believe is the original bearing tree to the Southeast and set an iron bar at the corner using the original government corner call. I expected this tree to be somewhat larger in diameter, but I believe the tree is a little stunted. I've observed sandstone bedrock close to the surface in the area. This wouldn't help tree growth. Also, it would appear that the tree always had to "fight for sun". There has been a woods to the East for some time. The tree has no limbs to the East, but has a protruding limb out to the West for a distance of 40 feet. The corner as set fits the line fence further South for line. The line fence to the East does not line up as well, but it appears a "little wild" as is the fence to the South for a ways. There is a kink at this corner that is more than I'm *****

Describe or show any material discrepancy between the location of the restored corner and that of the corner previously restored or reestablished.


NONE KNOWN.

***** (continued) used to finding in this township, though through the years I've found such kinks during the course of remonumentation. The Berntsen at the southeast corner of the section was set by me in 1985 and replaced an iron monument that had been there for several decades if not longer. I found an unrecorded pipe at the E1/16SE in the North-South fence. It fits about 2 foot N-S and about 2.8 feet E-W from the legal "40" corner. The evidence found at the SE section corner and the E1/16SE corner would seem to confirm that the East 1/4 corner as set is correct. The ground distance between the E1/4 and SE is 2639.57 feet. I have a theory that the kink at the E1/4 is probably due to an error in the original government survey.

RECORD OF DURABLE WITNESS MONUMENTS


NO	DESCRIPTION	MAGNETIC	
		BEARING	DISTANCE
1	SET A NAIL IN S.E.-SIDE OF A 12 1/2" HICKORY	N 38° E	60.97 FT.
2	SET A NAIL IN S.E.-SIDE OF A 13 1/2" BURR OAK	N 70° E	27.99 FT.
3	SET A NAIL IN S.-SIDE OF A 10" WHITE OAK	S 86° E	29.33 FT.
4	SET A NAIL IN S.W.-SIDE OF A 24 1/2" BURR OAK	S 05° E	16.50 FT.

(NOTE: BEARING TREES 1, 2 & 3 ARE DOUBLE BLAZED WHILE No. 4 WAS LEFT UNBLAZED.)

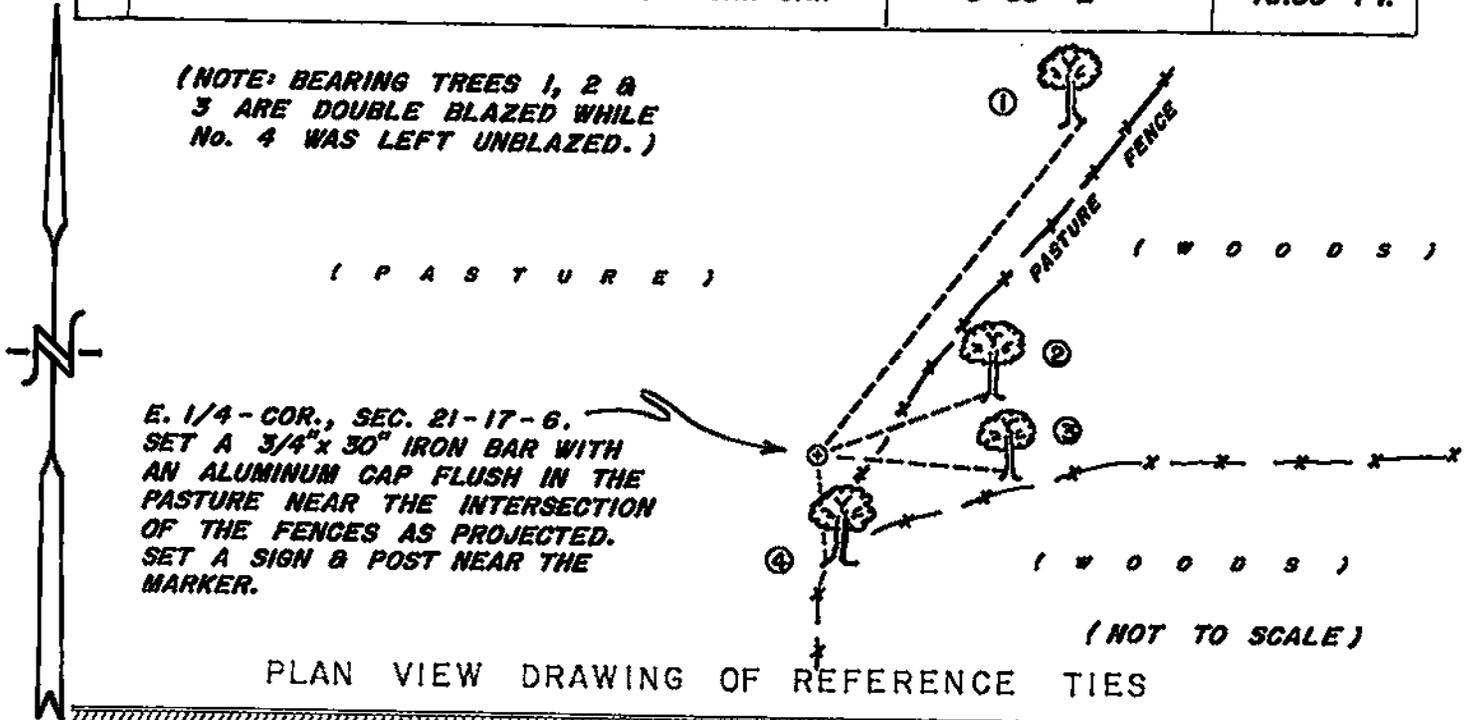

MAP SHOWING DISTANCE AND DIRECTION TO OTHER PUBLIC LAND SURVEY CORNERS USED FOR REESTABLISHING THE CORNER


(GRID BEARINGS AND DISTANCES)
 (GRID FACTOR: 0.999938)
 (NOT TO SCALE)

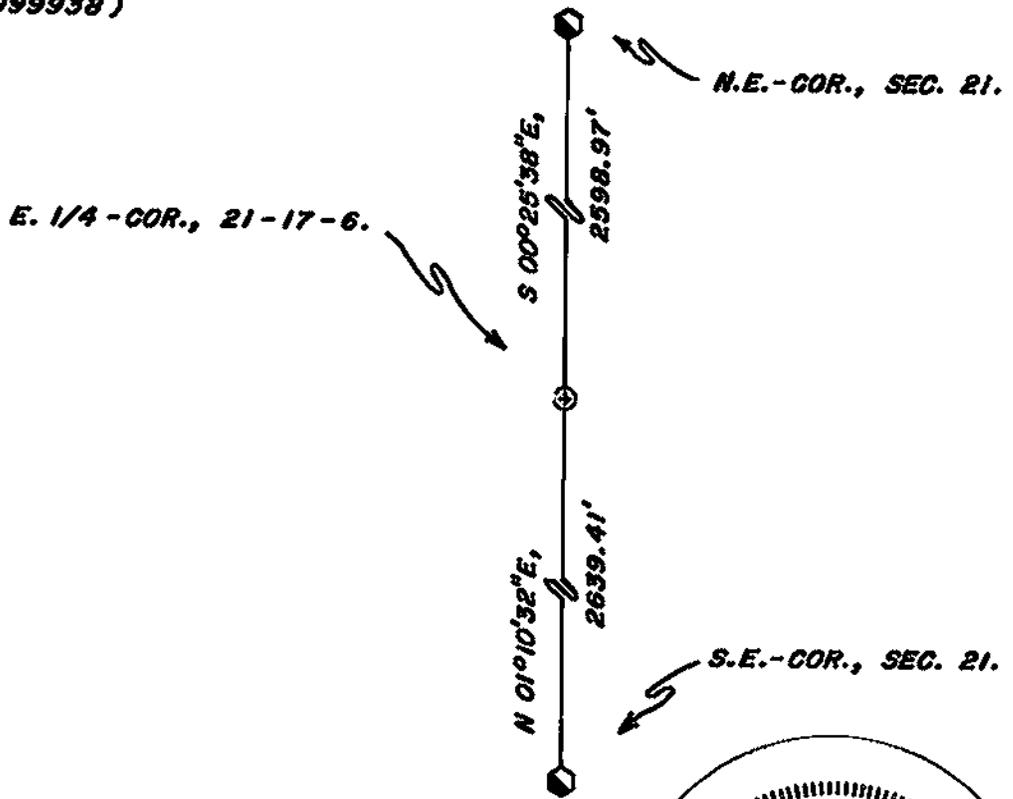

I, WILLIAM C. JUNG, COUNTY SURVEYOR
 HEREBY CERTIFY THAT THE CORNER LOCATION SHOWN ON THIS RECORD WAS DETERMINED BY ME OR UNDER MY DIRECTION AND CONTROL AND THAT THIS U. S. PUBLIC LAND SURVEY MONUMENT RECORD IS CORRECT AND COMPLETE TO THE BEST OF MY KNOWLEDGE AND BELIEF.

William C. Jung
 Signature

4/7/06
 Date

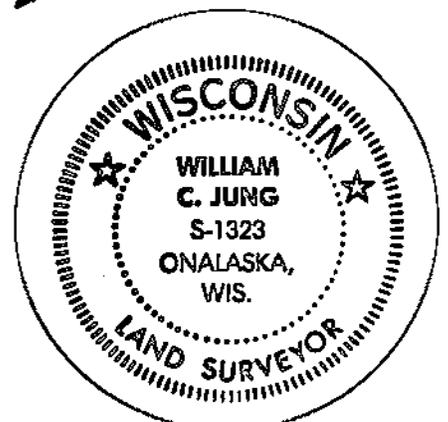

Seal