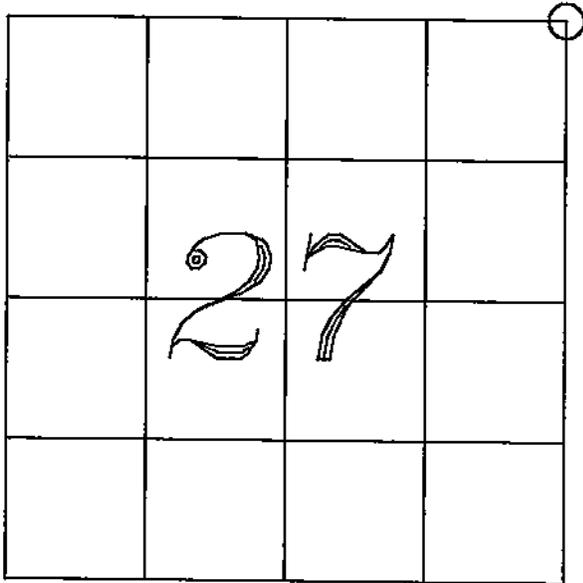


21706220000

## U. S. PUBLIC LAND SURVEY MONUMENT RECORD

SECTION 27 T 17 N, R 6 W, TOWN OF HAMILTON  
LA CROSSE COUNTY

LOCATION OF LANDMARK

CREW: Randy Corlis    Chris Fechner  
Kevin Kadrmas

DATE: 05/06/2005

Describe any record evidence, monument evidence, testimonial evidence, or any other material evidence you considered and whether the monument was found or restored through acceptance of an obliterated evidence location.

There was no perpetuation of corner location since original government survey. No evidence of corner location was found near the calculated position. However, a north-south fence was located approximately 300 feet south of the newly restored corner. It fell within a few feet of an even split between the north 1/4 corner of section 26 and the north 1/4 corner of section 27. The measurement south fits very well to the original call of 40 chains.

Describe or show any material discrepancy between the location of the restored corner and that of the corner previously restored or reestablished.

None known.

WISCONSIN COORDINATE SYSTEM
North
East
Theta Angle
Horiz. Order
Vert. Order
TYPE OF LANDMARK
3/4" x 24" IRON BAR
BEARINGS ARE REFERENCED TO
La Crosse County Coordinate System


RECEIVED

SEP 22 2005

COUNTY SURVEYOR'S OFFICE


## RECORD OF DURABLE WITNESS MONUMENTS

NO	DESCRIPTION	BEARING	DISTANCE
1	SET 3/4" x 24" IRON BAR	N 89°24'53" E	56.54'
2	SET 3/4" x 24" IRON BAR	S 02°38'28" E	77.69'
3	SET 3/4" x 24" IRON BAR	S 28°24'07" W	105.17'
4	SET 1" IRON PIPE	S 73°16'12" W	147.17'

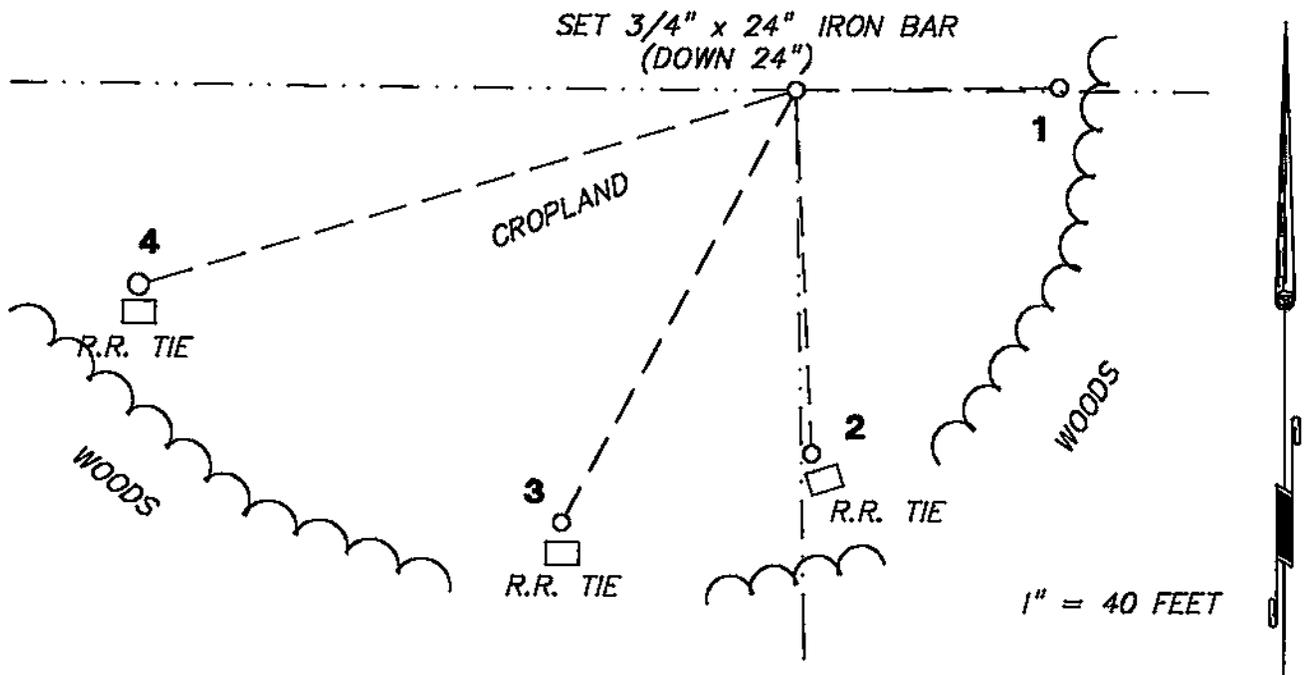

PLAN VIEW DRAWING OF REFERENCE TIES

### MAP SHOWING DISTANCE AND DIRECTION TO OTHER PUBLIC LAND SURVEY CORNERS USED FOR REESTABLISHING THE CORNER

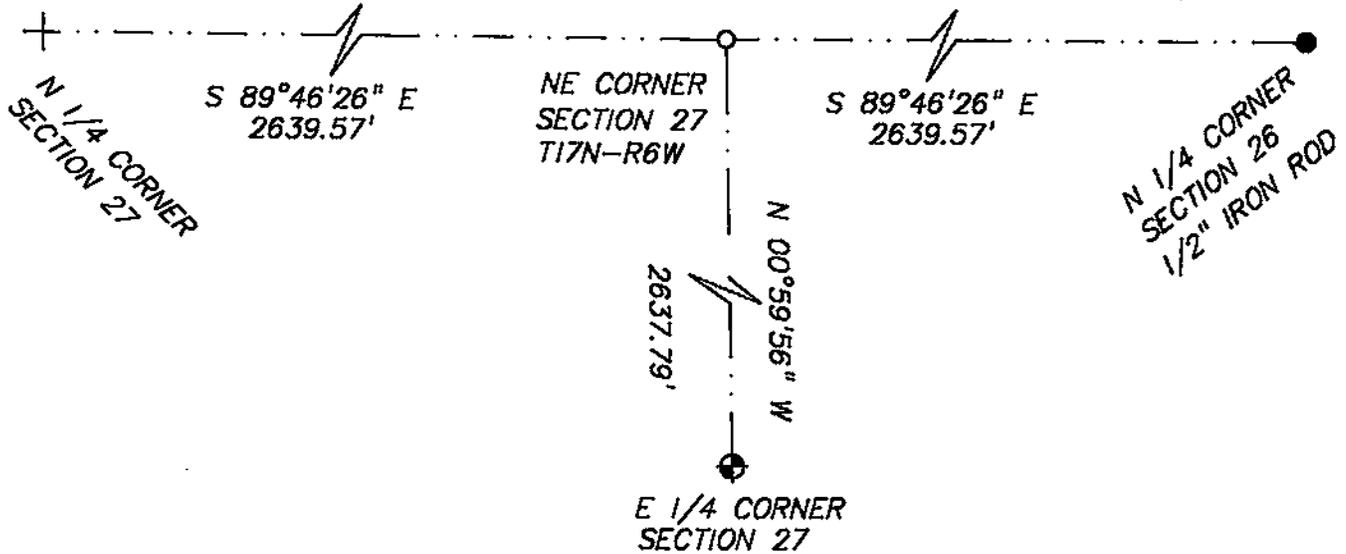

I, Christopher W. Fechner  
 HEREBY CERTIFY THAT THE CORNER LOCATION SHOWN ON THIS RECORD  
 WAS DETERMINED BY ME OR UNDER MY DIRECTION AND CONTROL AND  
 THAT THIS U. S. PUBLIC LAND SURVEY MONUMENT RECORD IS CORRECT  
 AND COMPLETE TO THE BEST OF MY KNOWLEDGE AND BELIEF.

Christopher W. Fechner

Signature

Date

7/19/05



Seal